




APPROVED
First Floor
Scale 1:200

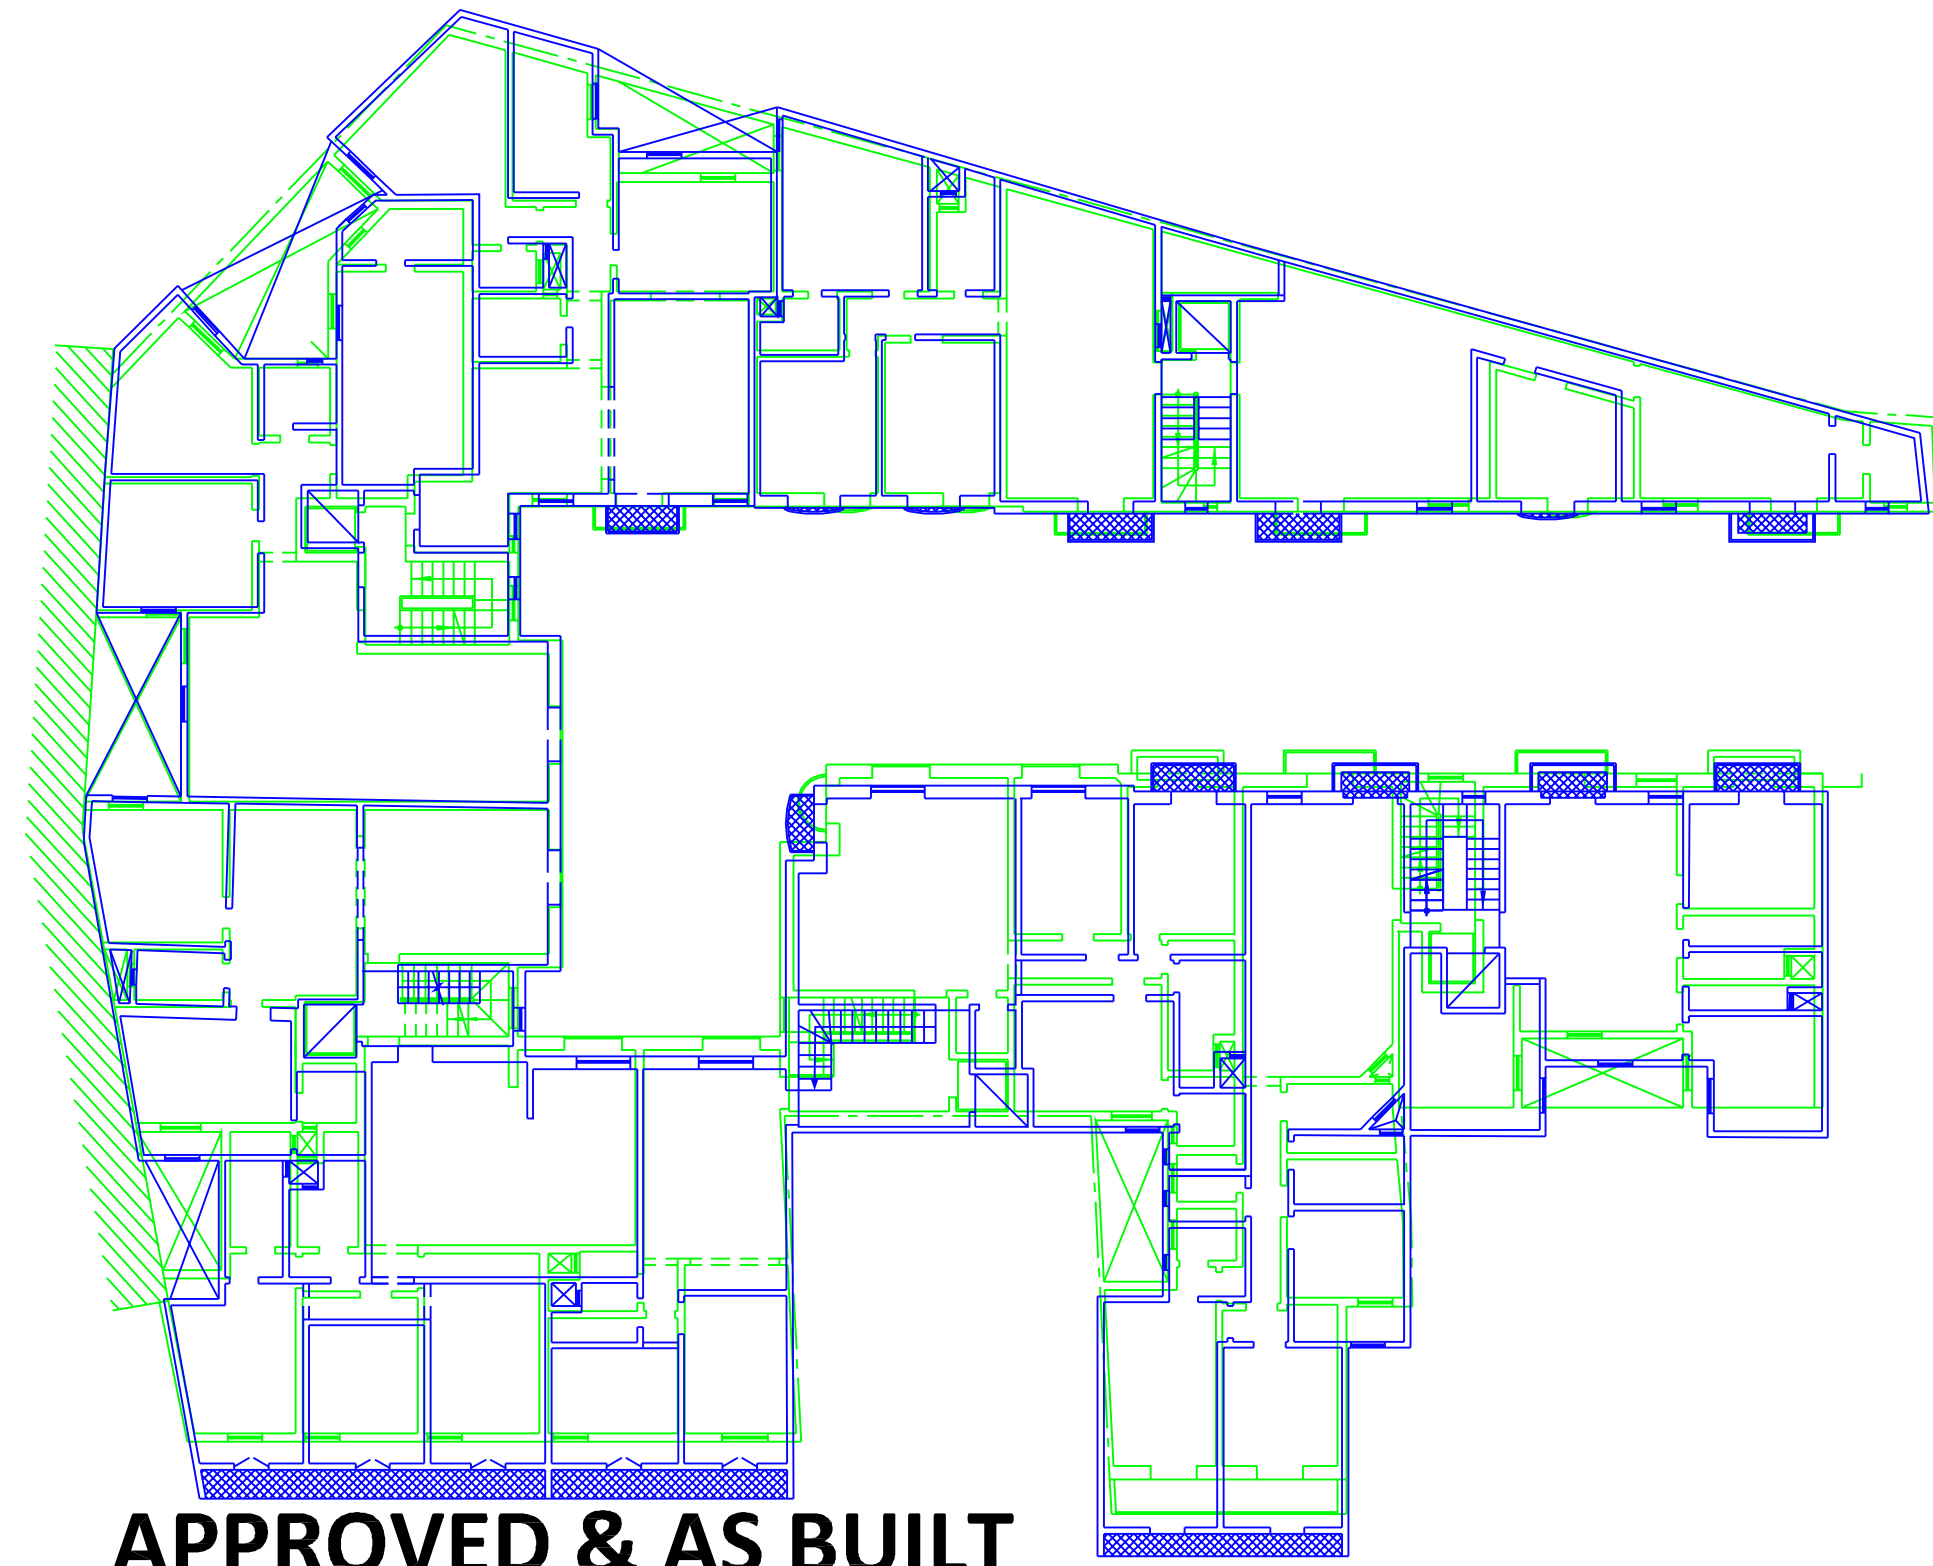

APPROVED & AS BUILT
First Floor
Scale 1:200

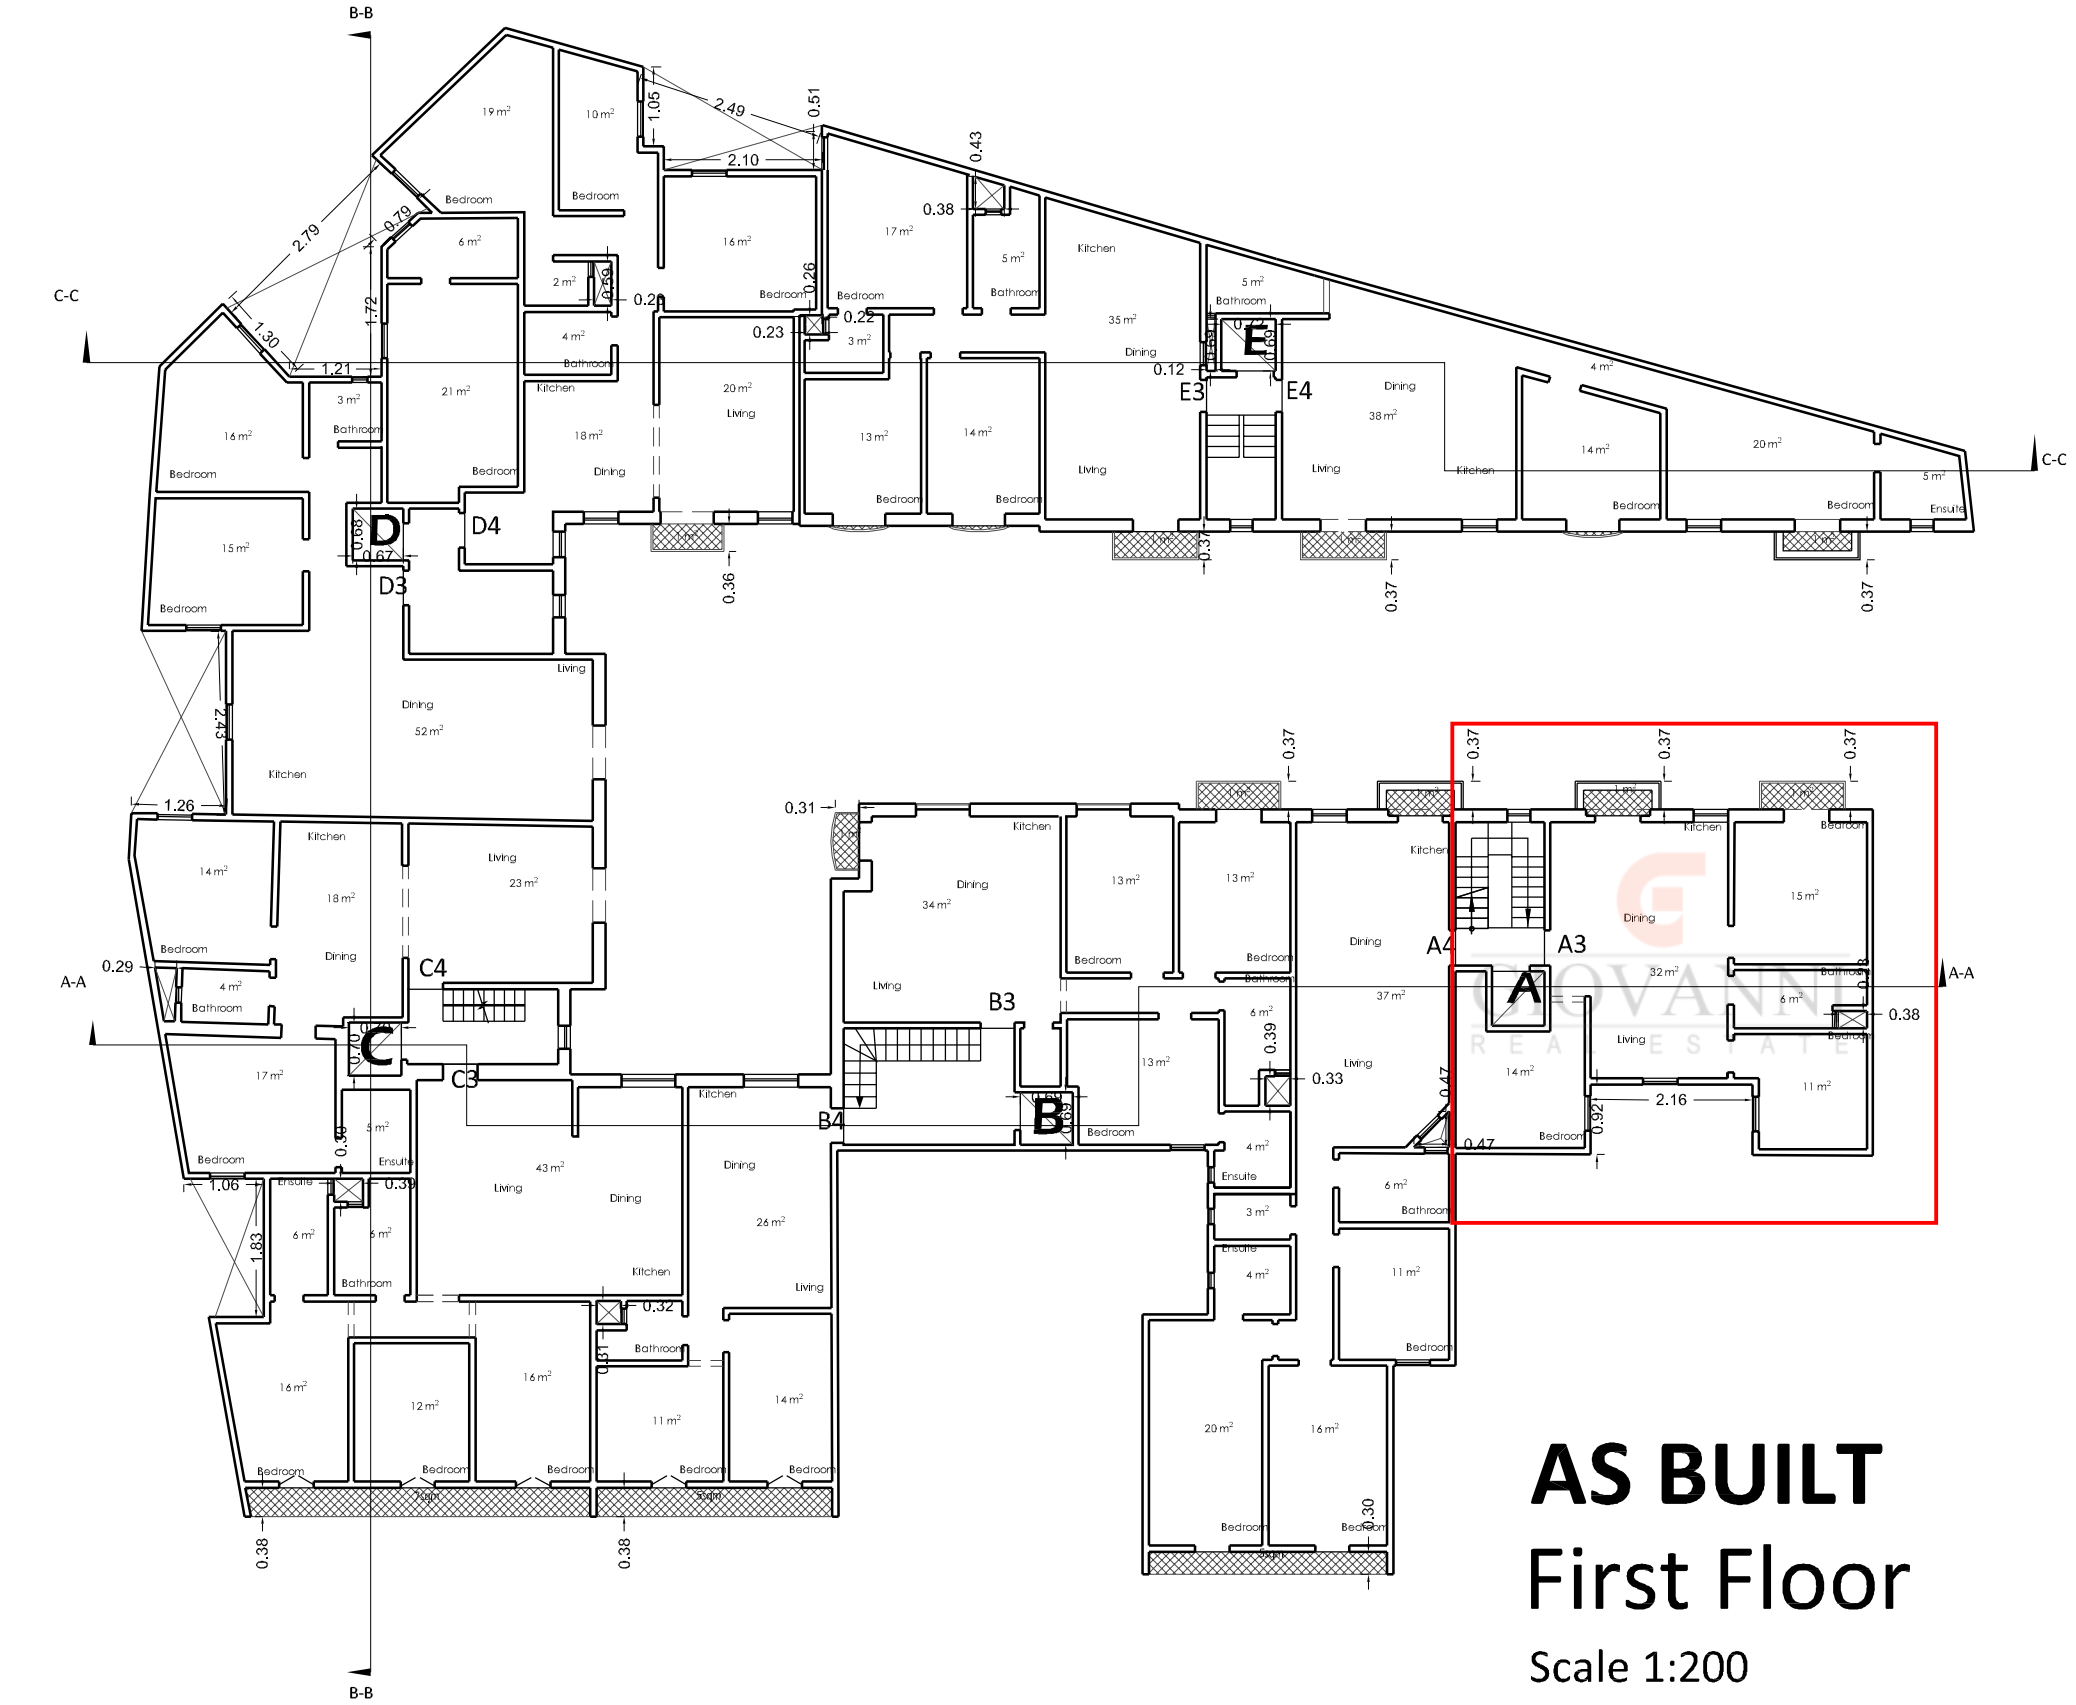



AS BUILT
First Floor
Scale 1:200

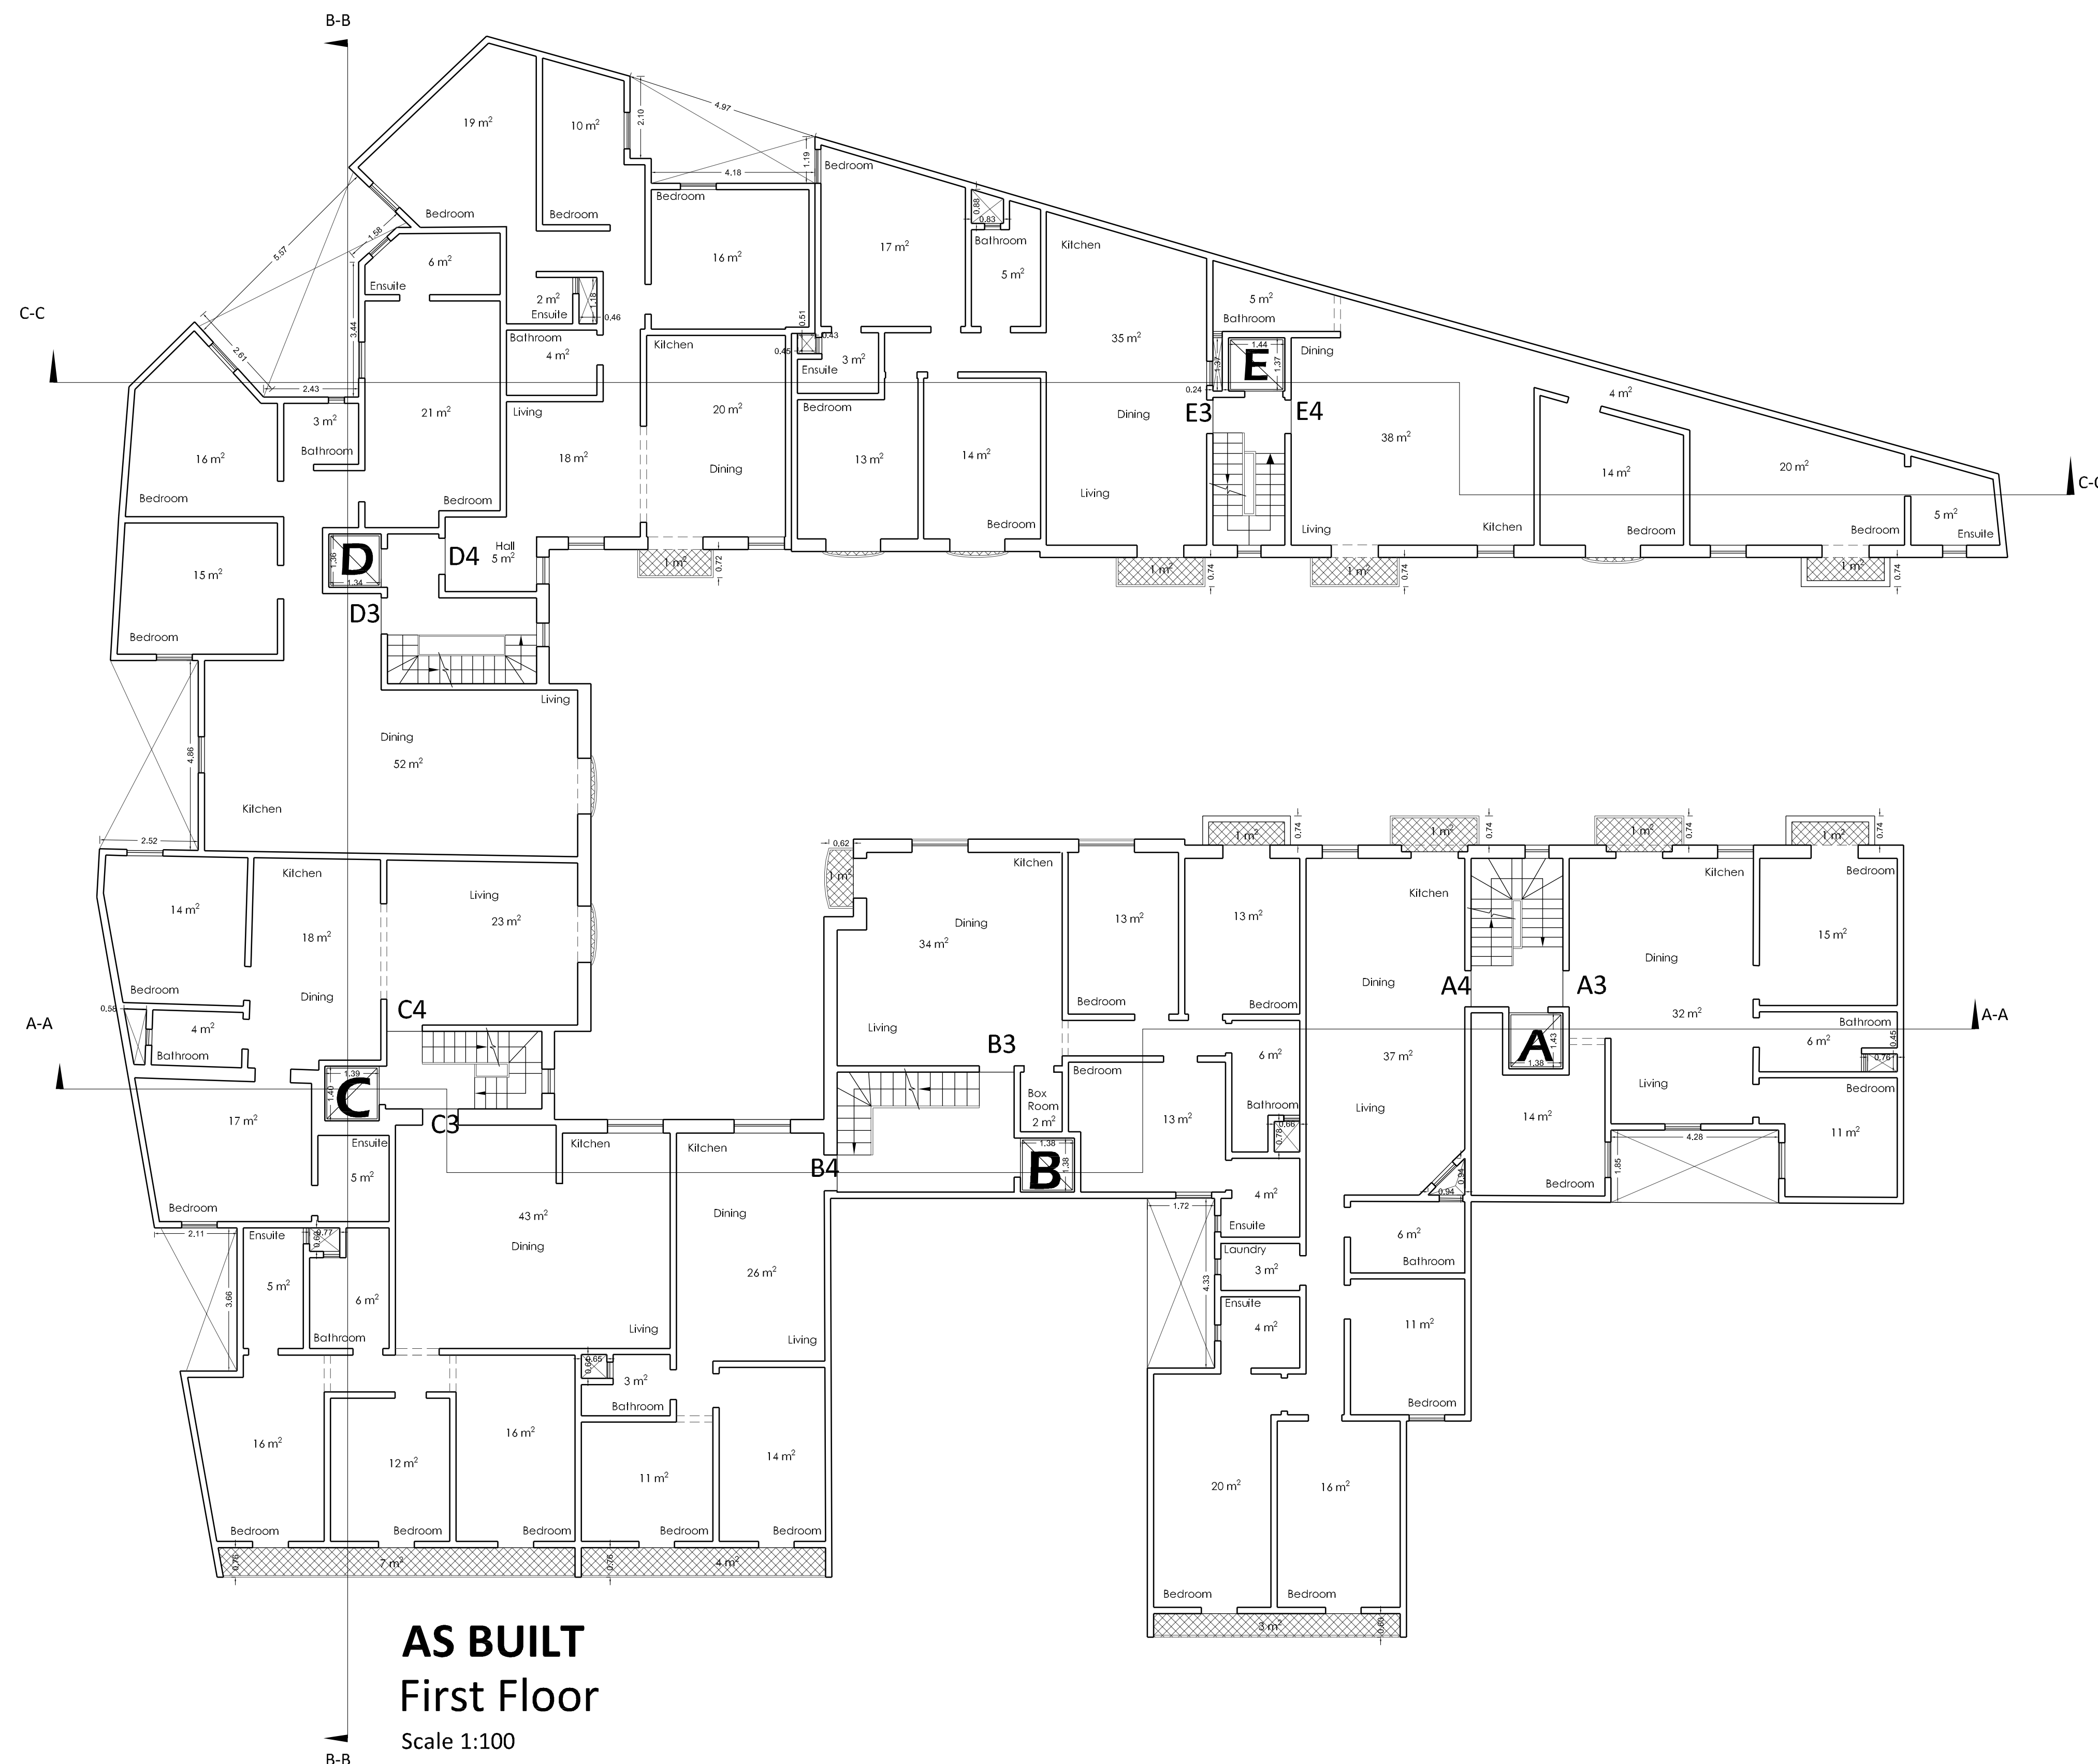

AS BUILT
First Floor
Scale 1:100

GFA details		
Aprt. No.	Internal	External
A3	81 sqm	3 sqm
A4	106 sqm	3 sqm
B3	94 sqm	1 sqm
B4	56 sqm	5 sqm
C3	104 sqm	7 sqm
C4	79 sqm	6 sqm
D3	119 sqm	0 sqm
D4	99 sqm	1 sqm
E3	95 sqm	1 sqm
E4	89 sqm	1 sqm

Note: All bedroom windows add up to at least 1 sqm

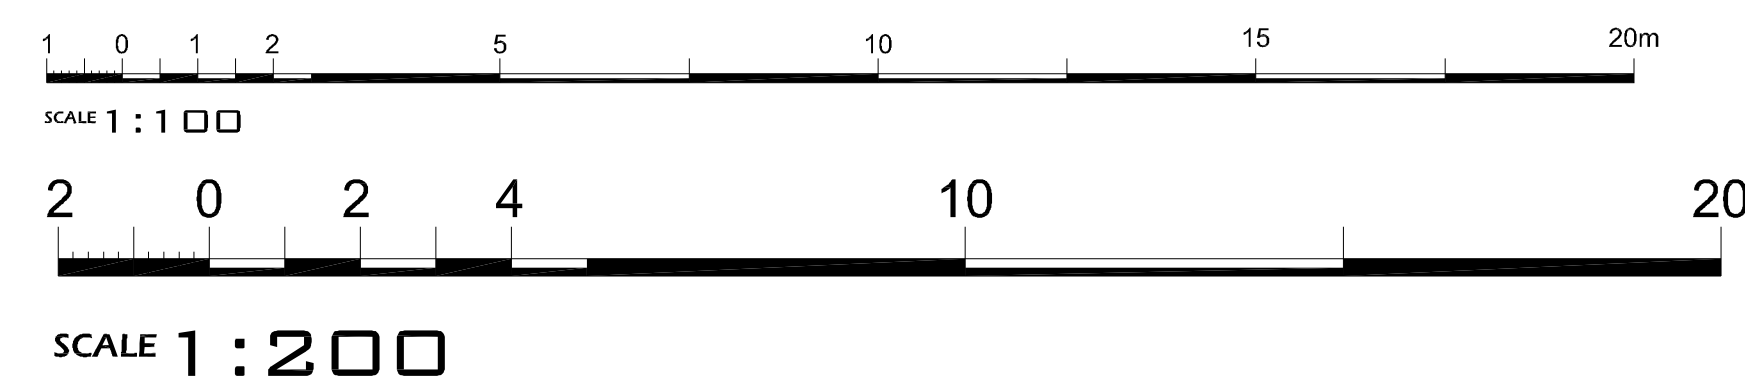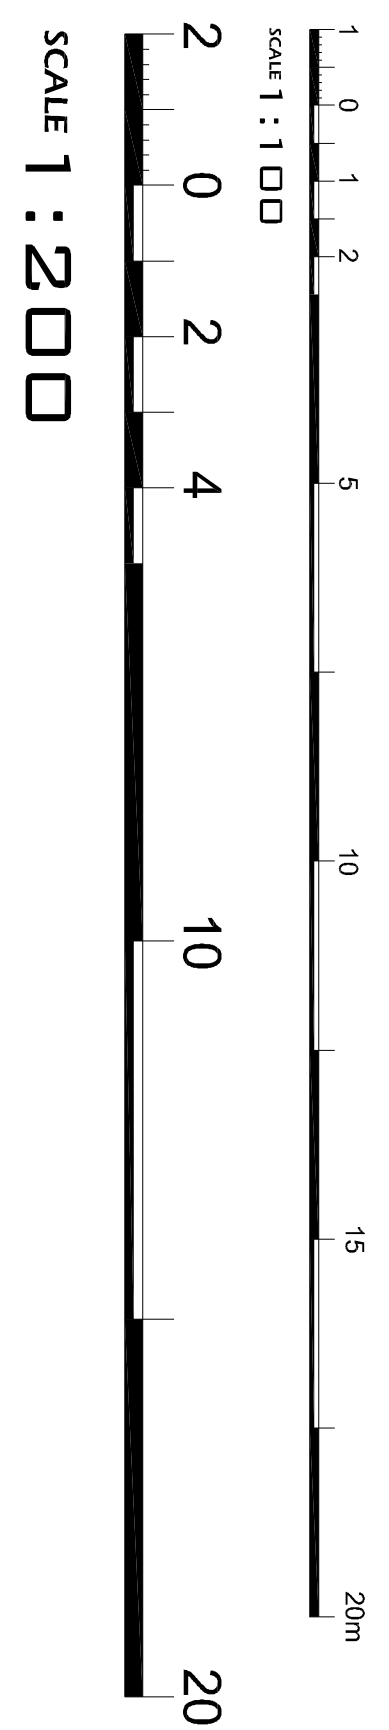

SCALE 1:200