



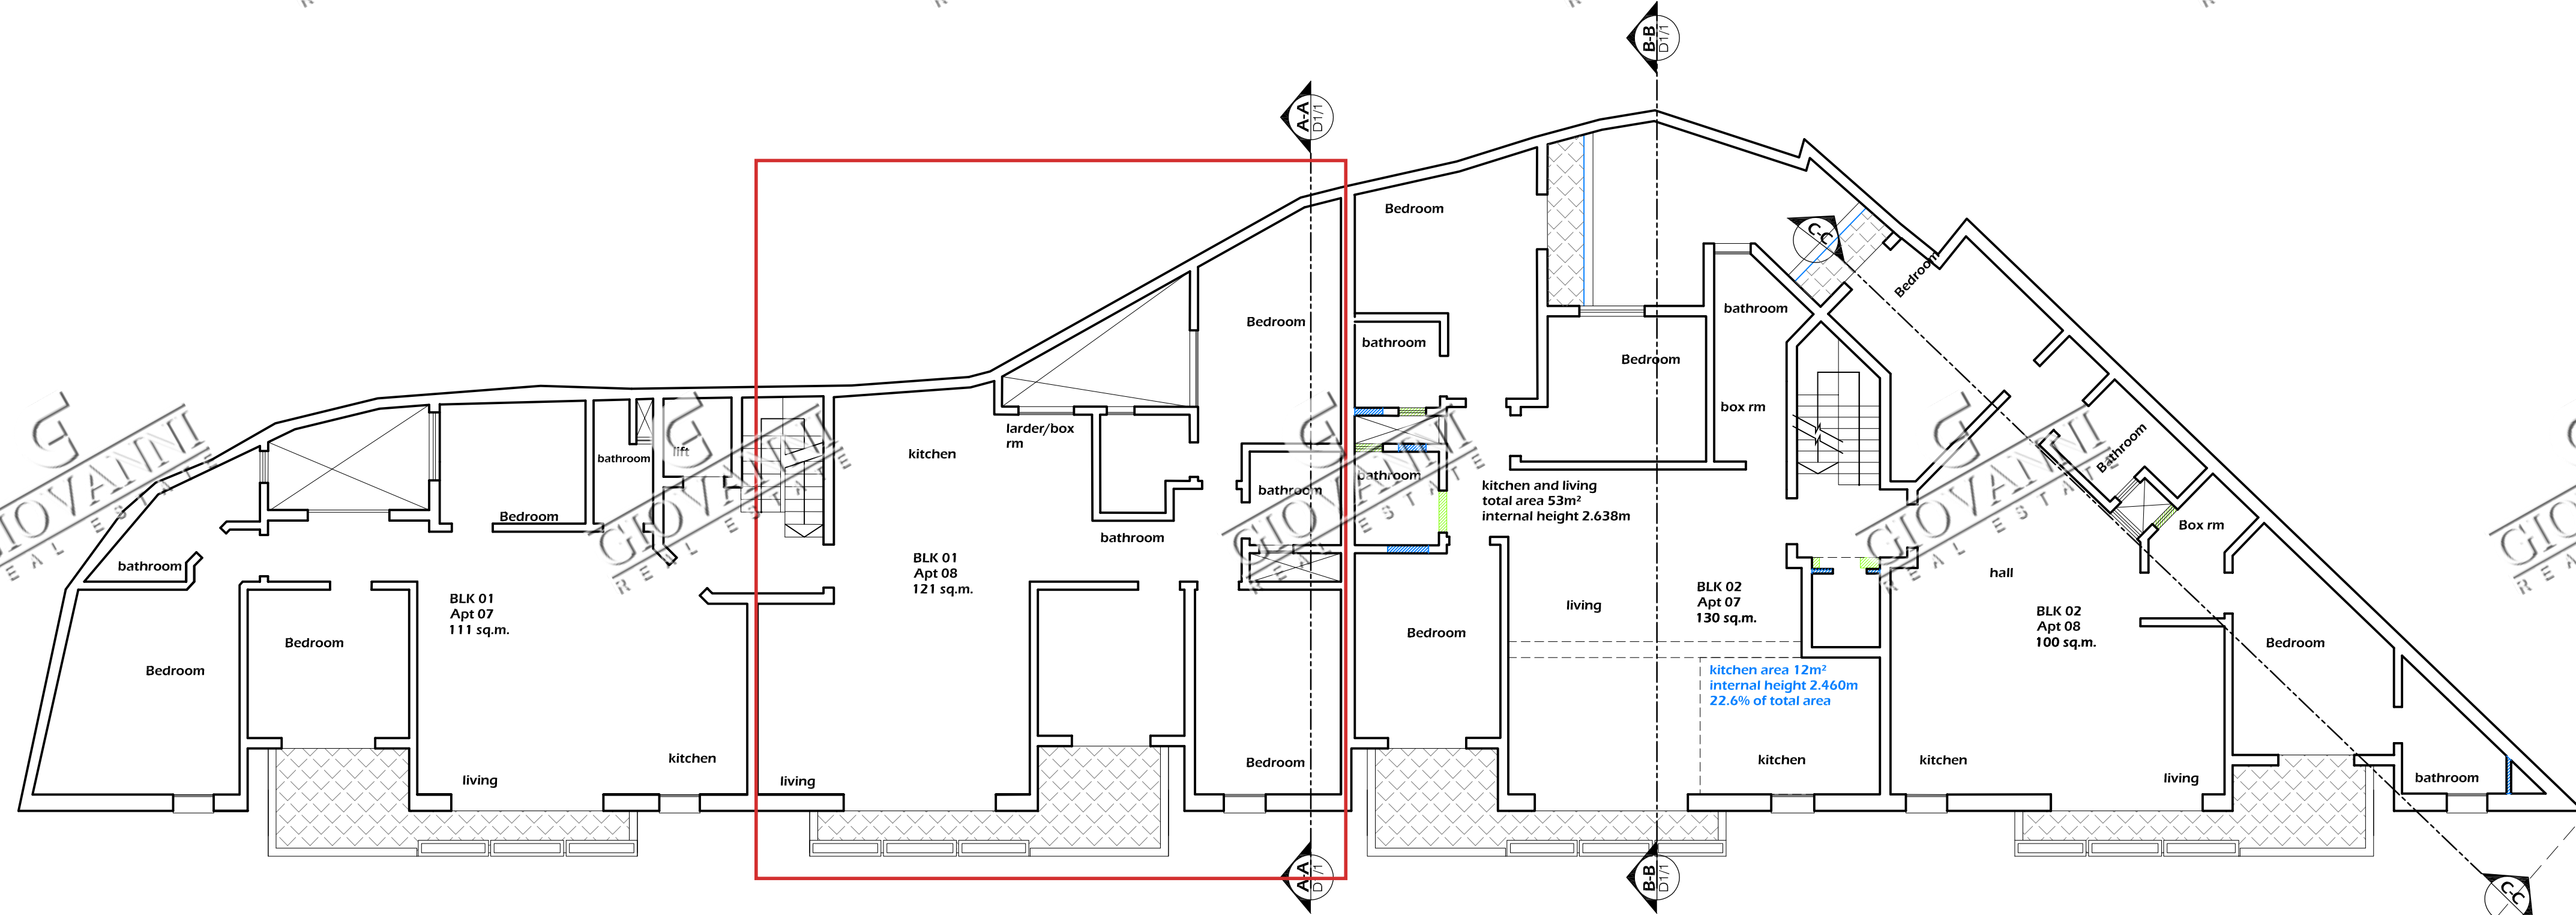



Approved/ As built **Third floor plan**

Scale 1:100

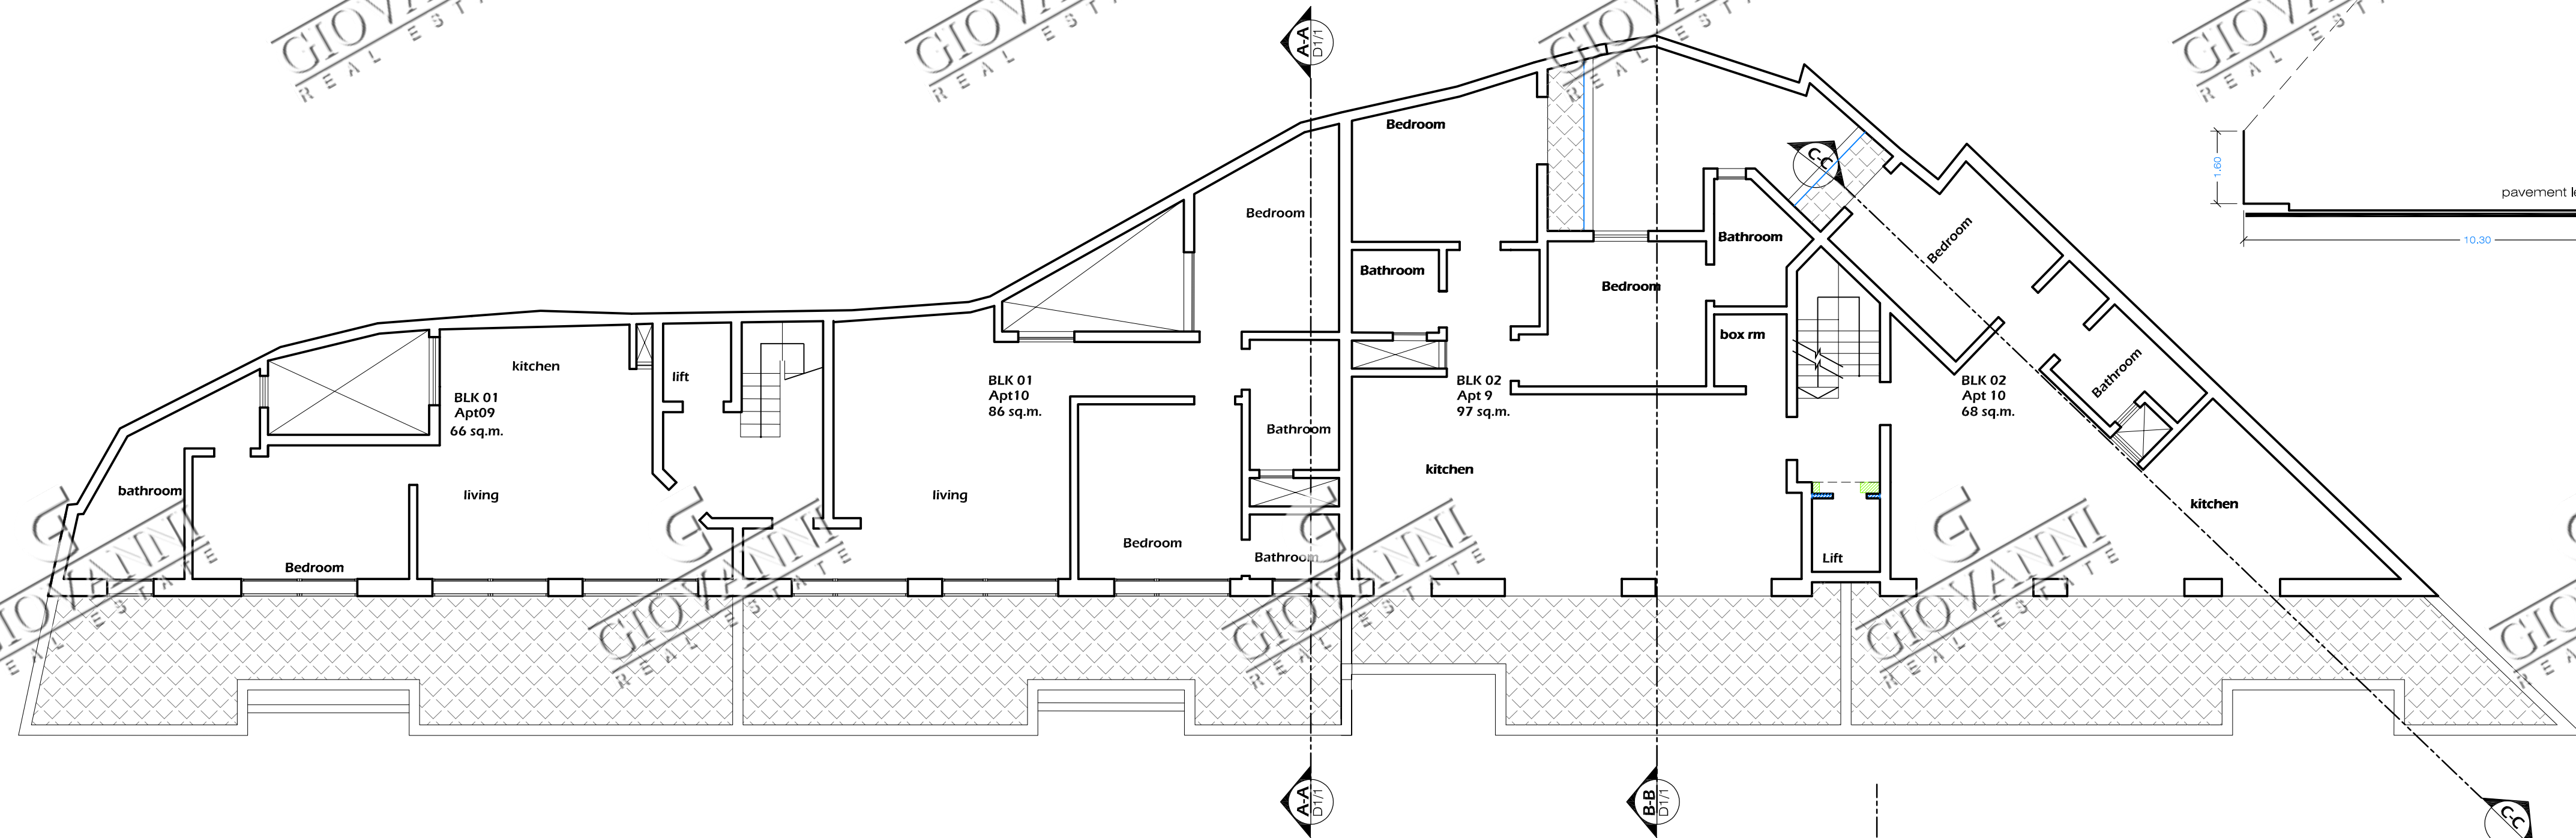


Approved/ As built **receded floor plan**

Scale 1:100

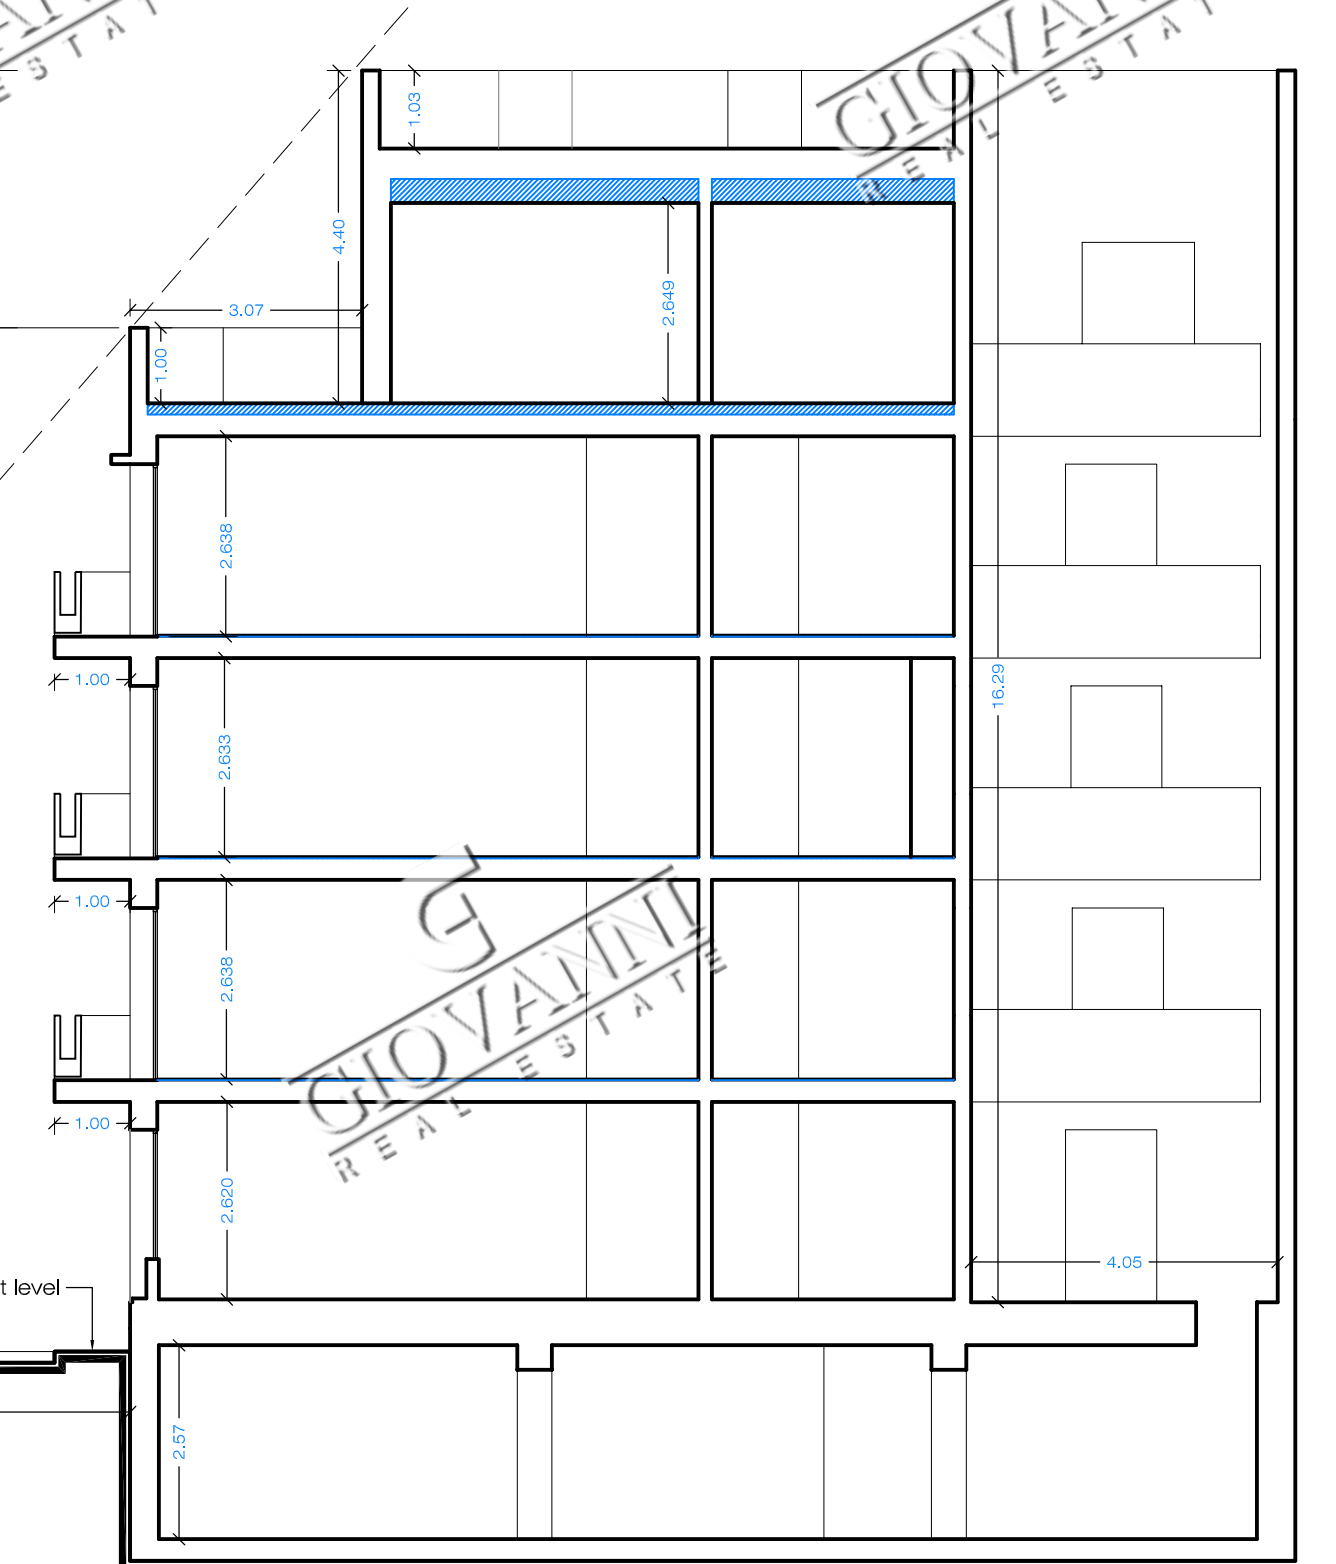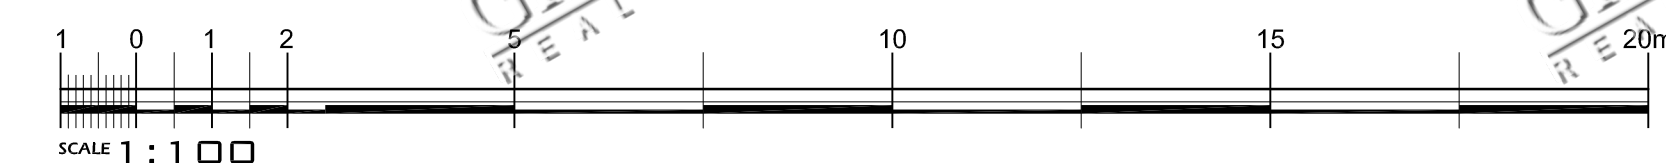

Approved / As built **section BB**

Scale 1:100

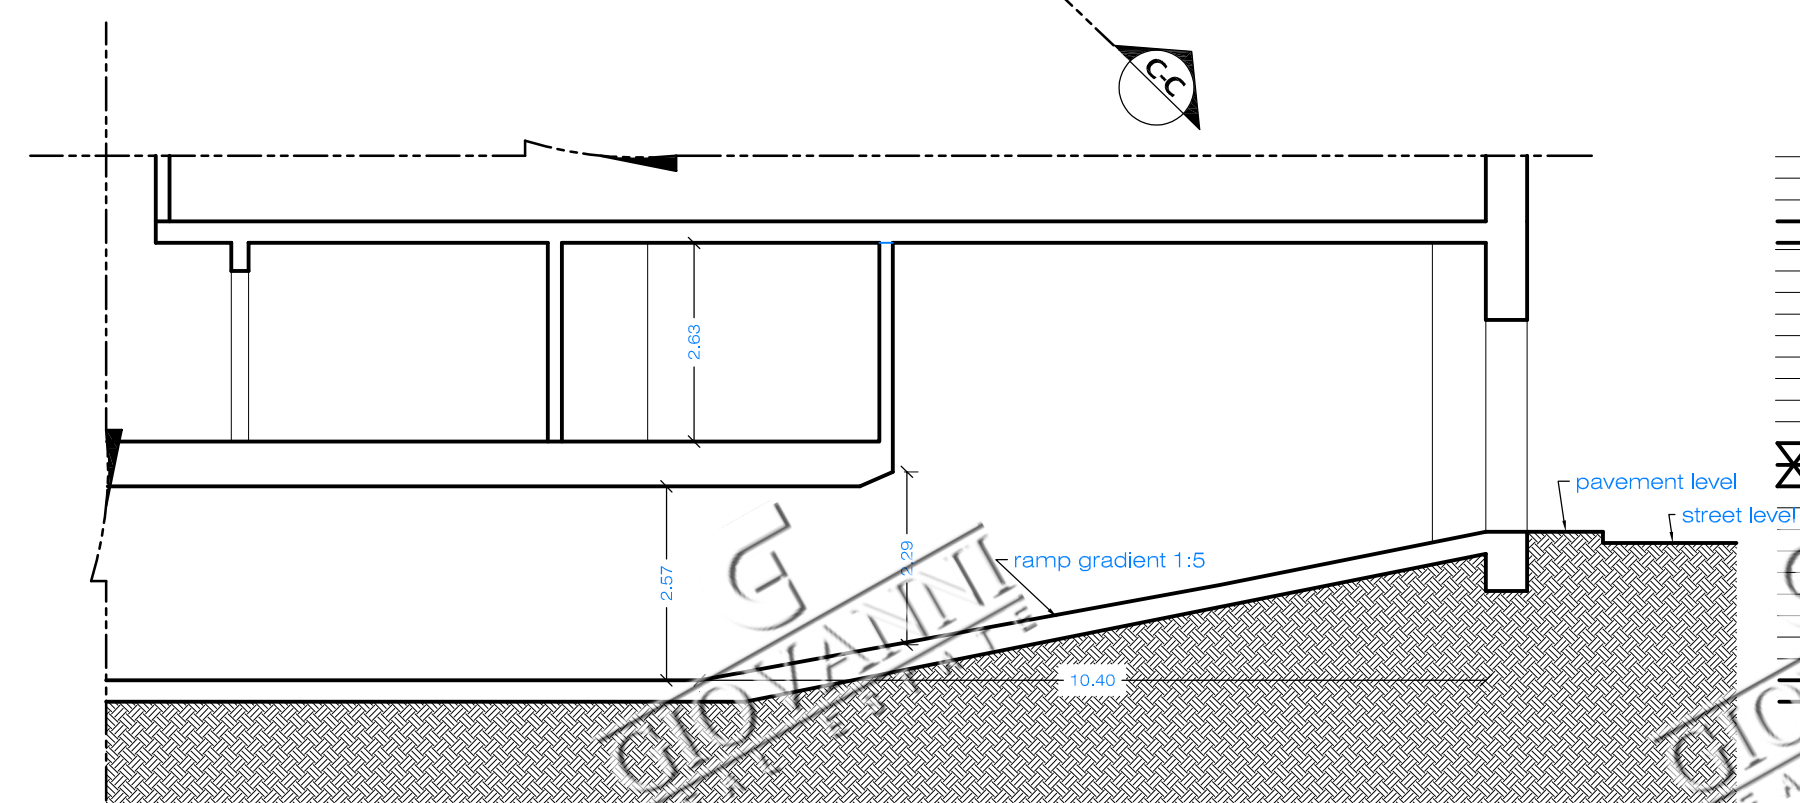

Approved/ As built **section CC through ramp**

Scale 1:100