




FRONT ELEVATION


As Existing

Scale 1:50

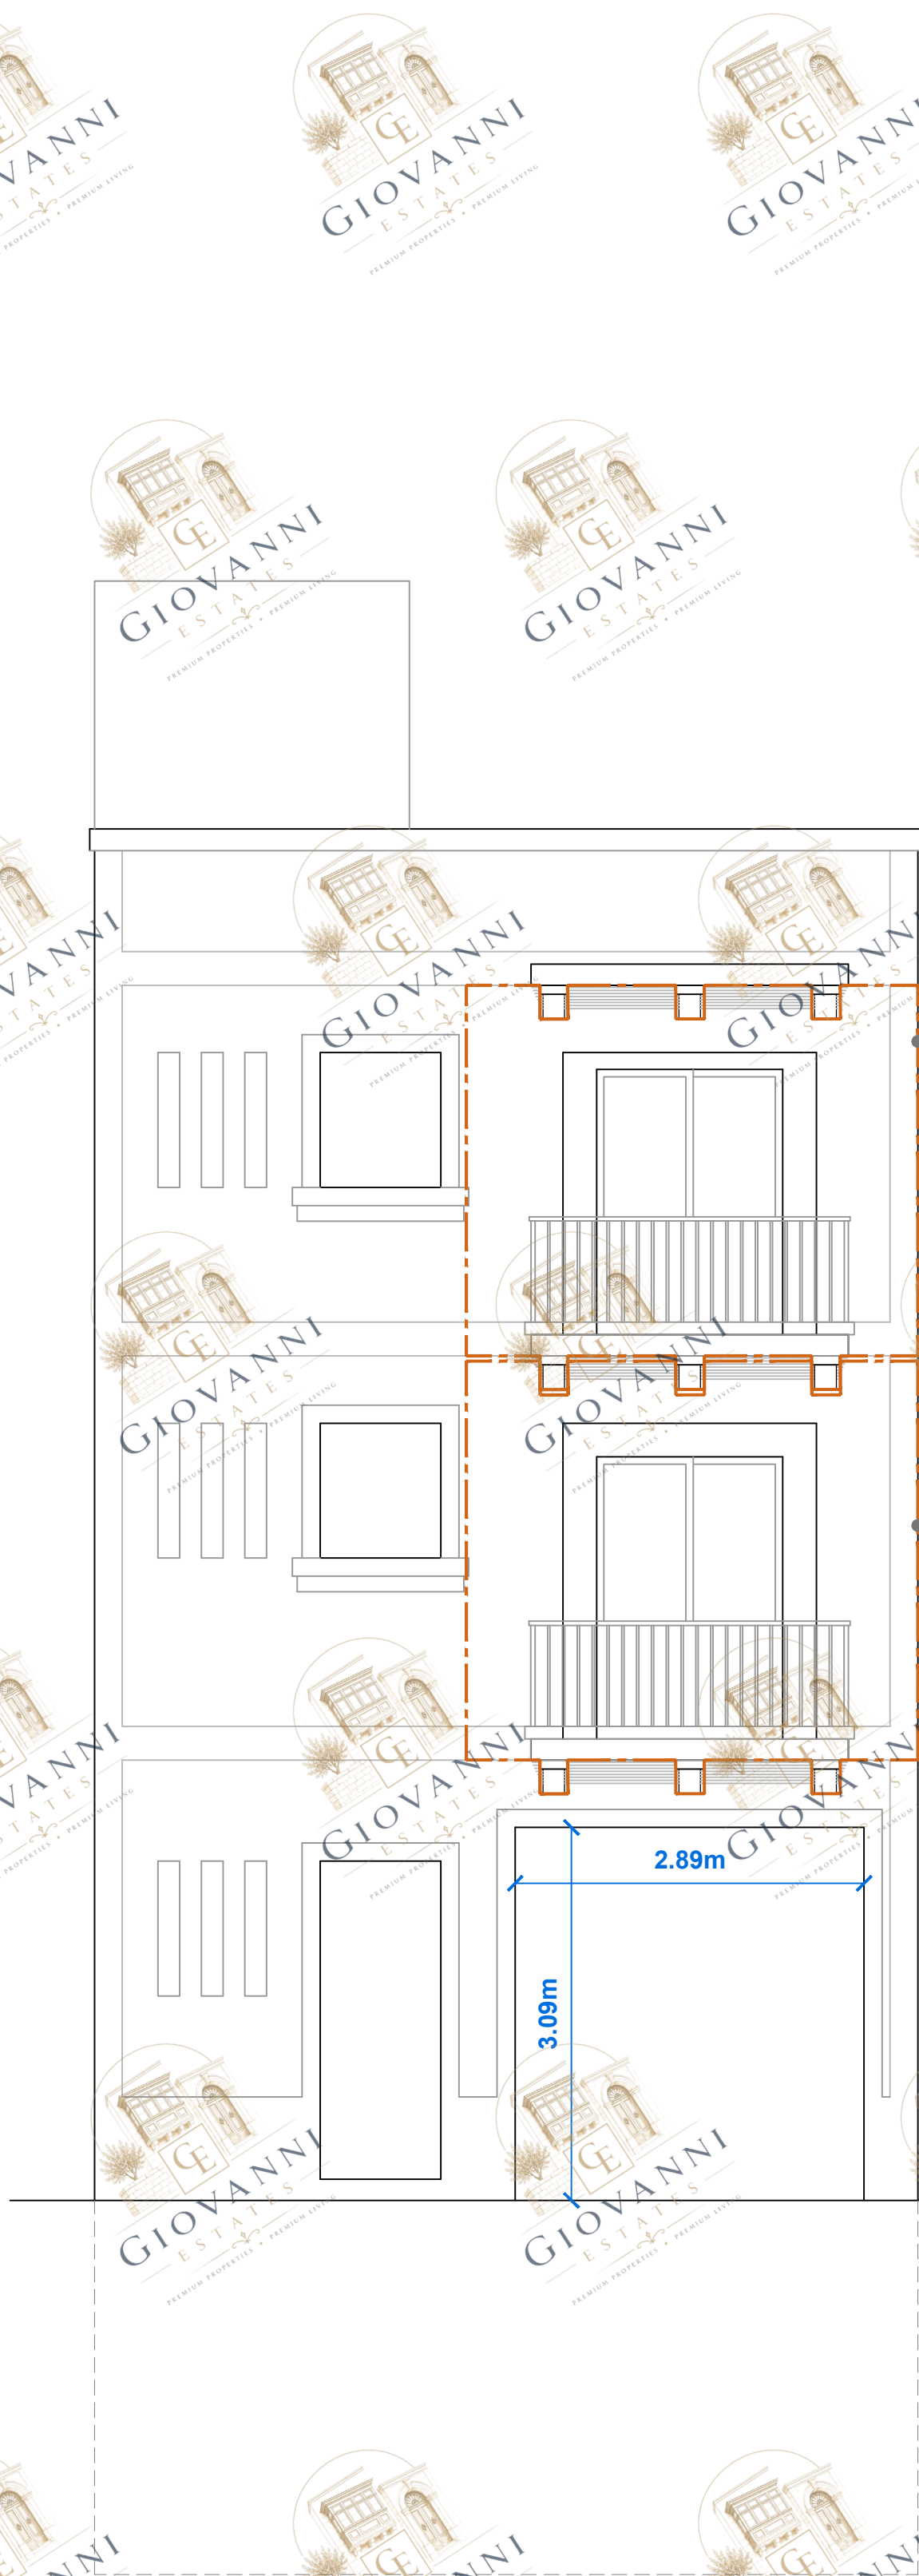

AS PROPOSED (TO DEMOLISH)


AS PROPOSED (TO CONSTRUCT)

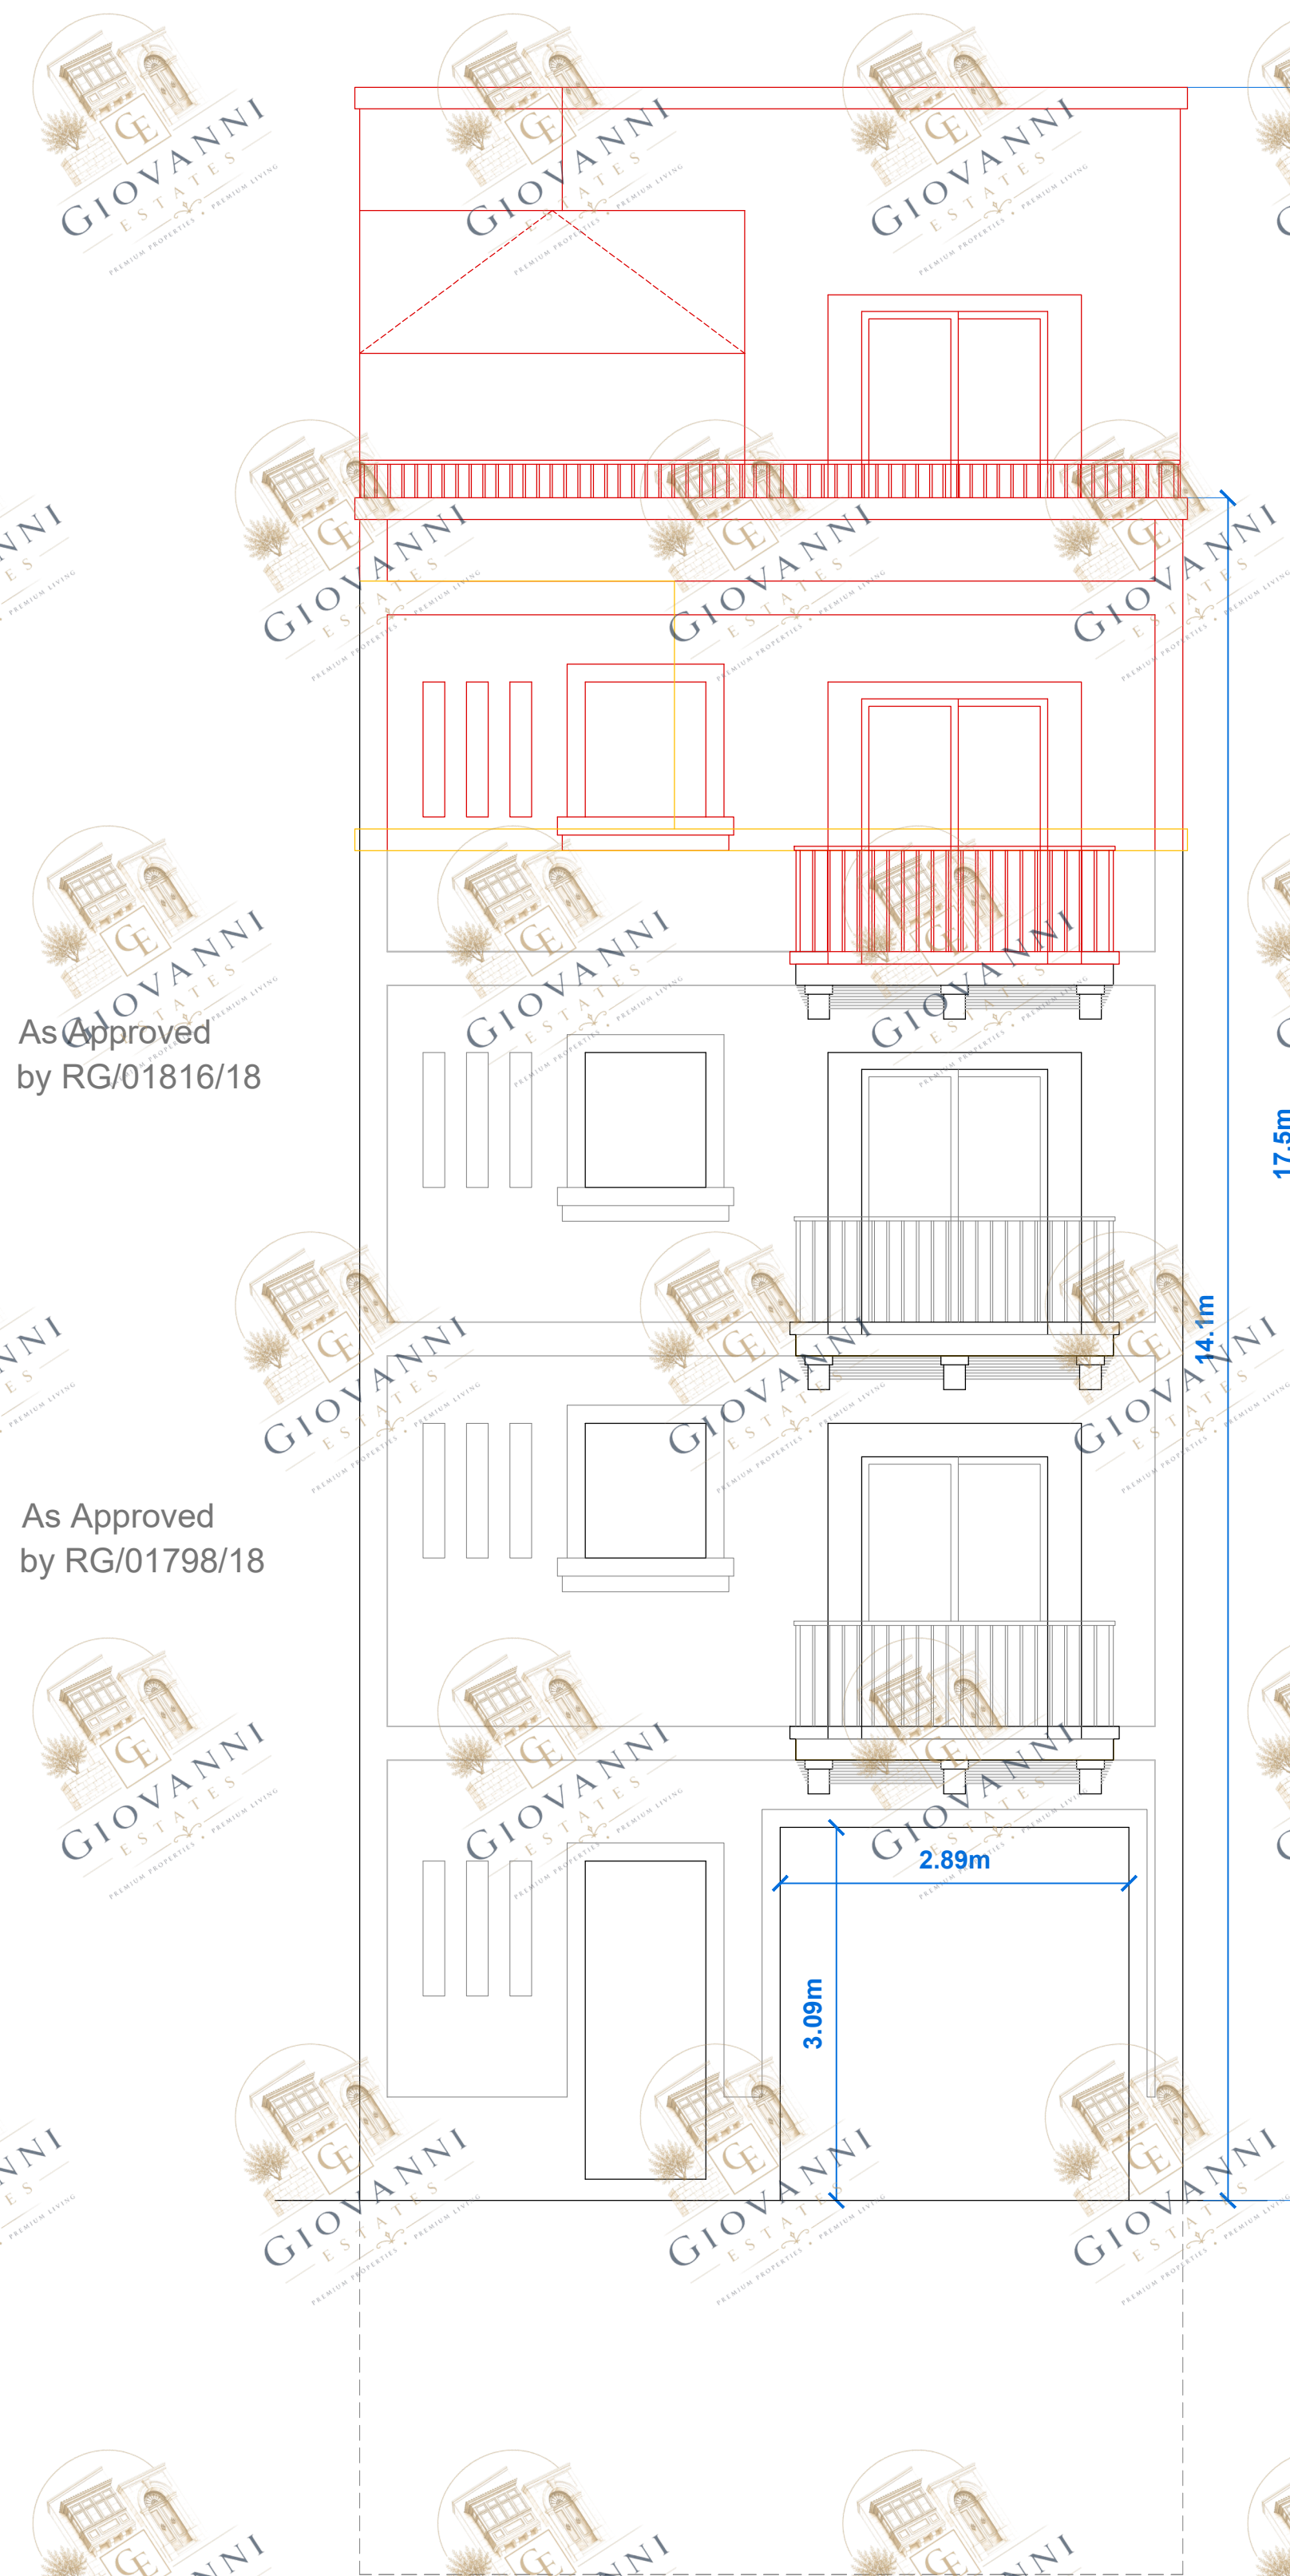

FRONT ELEVATION

Showing Variations

Scale 1:50

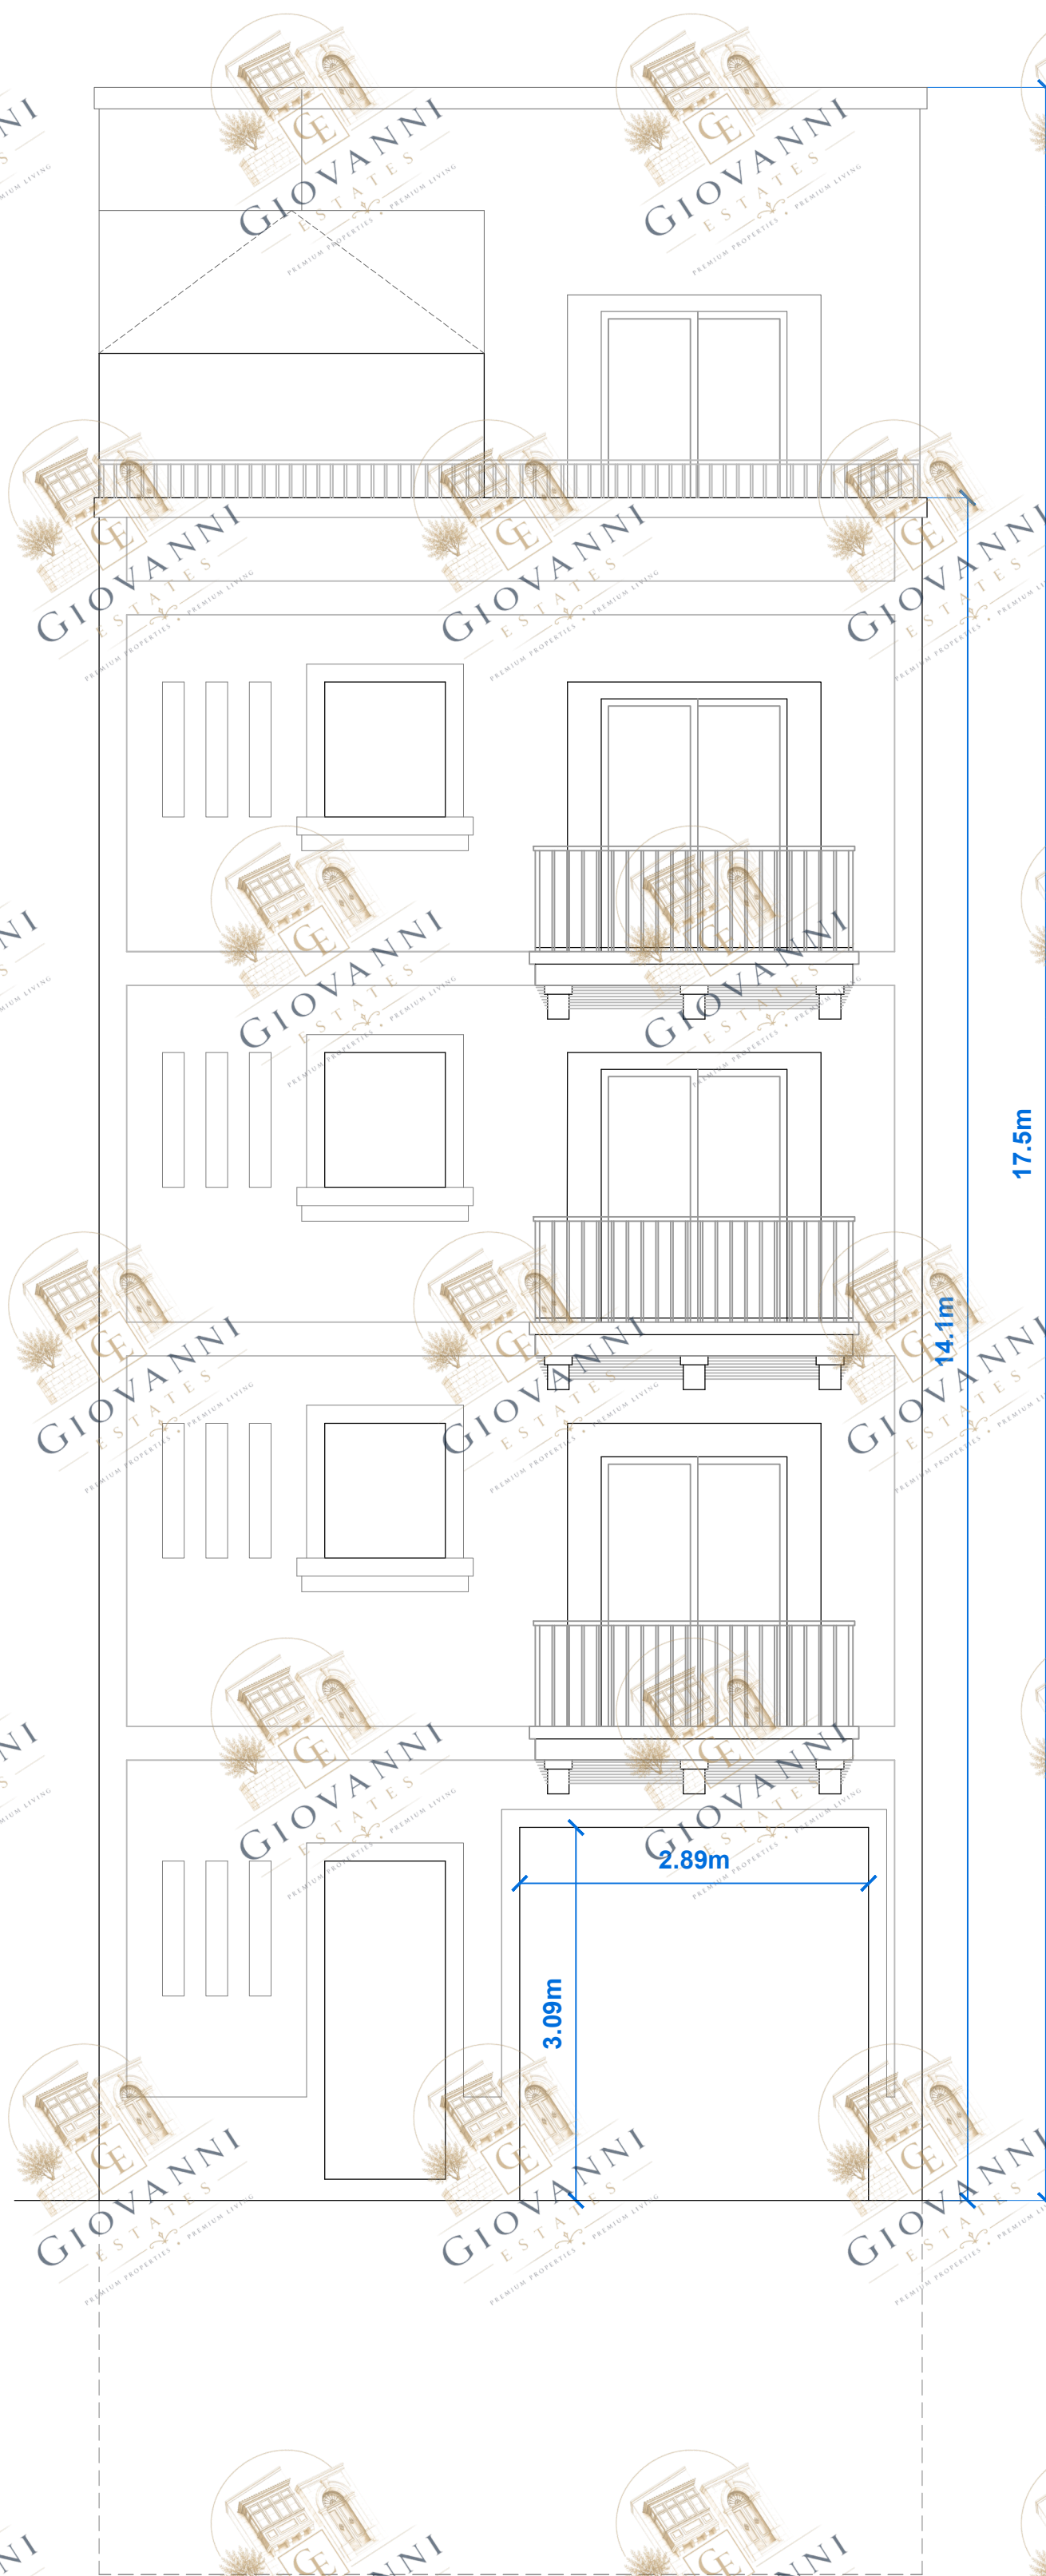

FRONT ELEVATION

As Proposed

Scale 1:50

Note

1. Drawings are based on survey data and may not accurately represent what is physically present.
2. Do not scale from this drawing. All dimensions to be site verified by the contractor before proceeding.
3. All dimensions are in millimetres unless noted otherwise.
4. The project architect shall be notified in writing of any discrepancies.

Copyright

All rights to the drawings and designs are held by Vella + Grech Periti. Reproducing, sharing, or storing any part of this content, either in 2D or 3D format, by any method – including digital, photocopying, or other mechanical processes – without written consent from the copyright holder is strictly prohibited.

The content cannot be saved in any digital storage system without the copyright holder's written agreement. The rights and identification of the original creator for these designs are reserved.

The drawings and designs were produced by the copyright holder under an exclusive agreement for a specific client. Use of this content is restricted to this client based on the license's terms. Any permissions granted by the copyright holder under this license cease once the license ends or if the licensee faces insolvency issues.

Vella + Grech Periti disclaims any liability for unauthorised or unlicensed use of the designs and for any actions based on them. Construction based on these designs is not allowed unless there's explicit written approval from the copyright holder.

Address:


Triq l-Arcisqof Pietru Pace
Victoria, Gozo

Contact:

info@vgperiti.com
+356 21 551 963

Scale



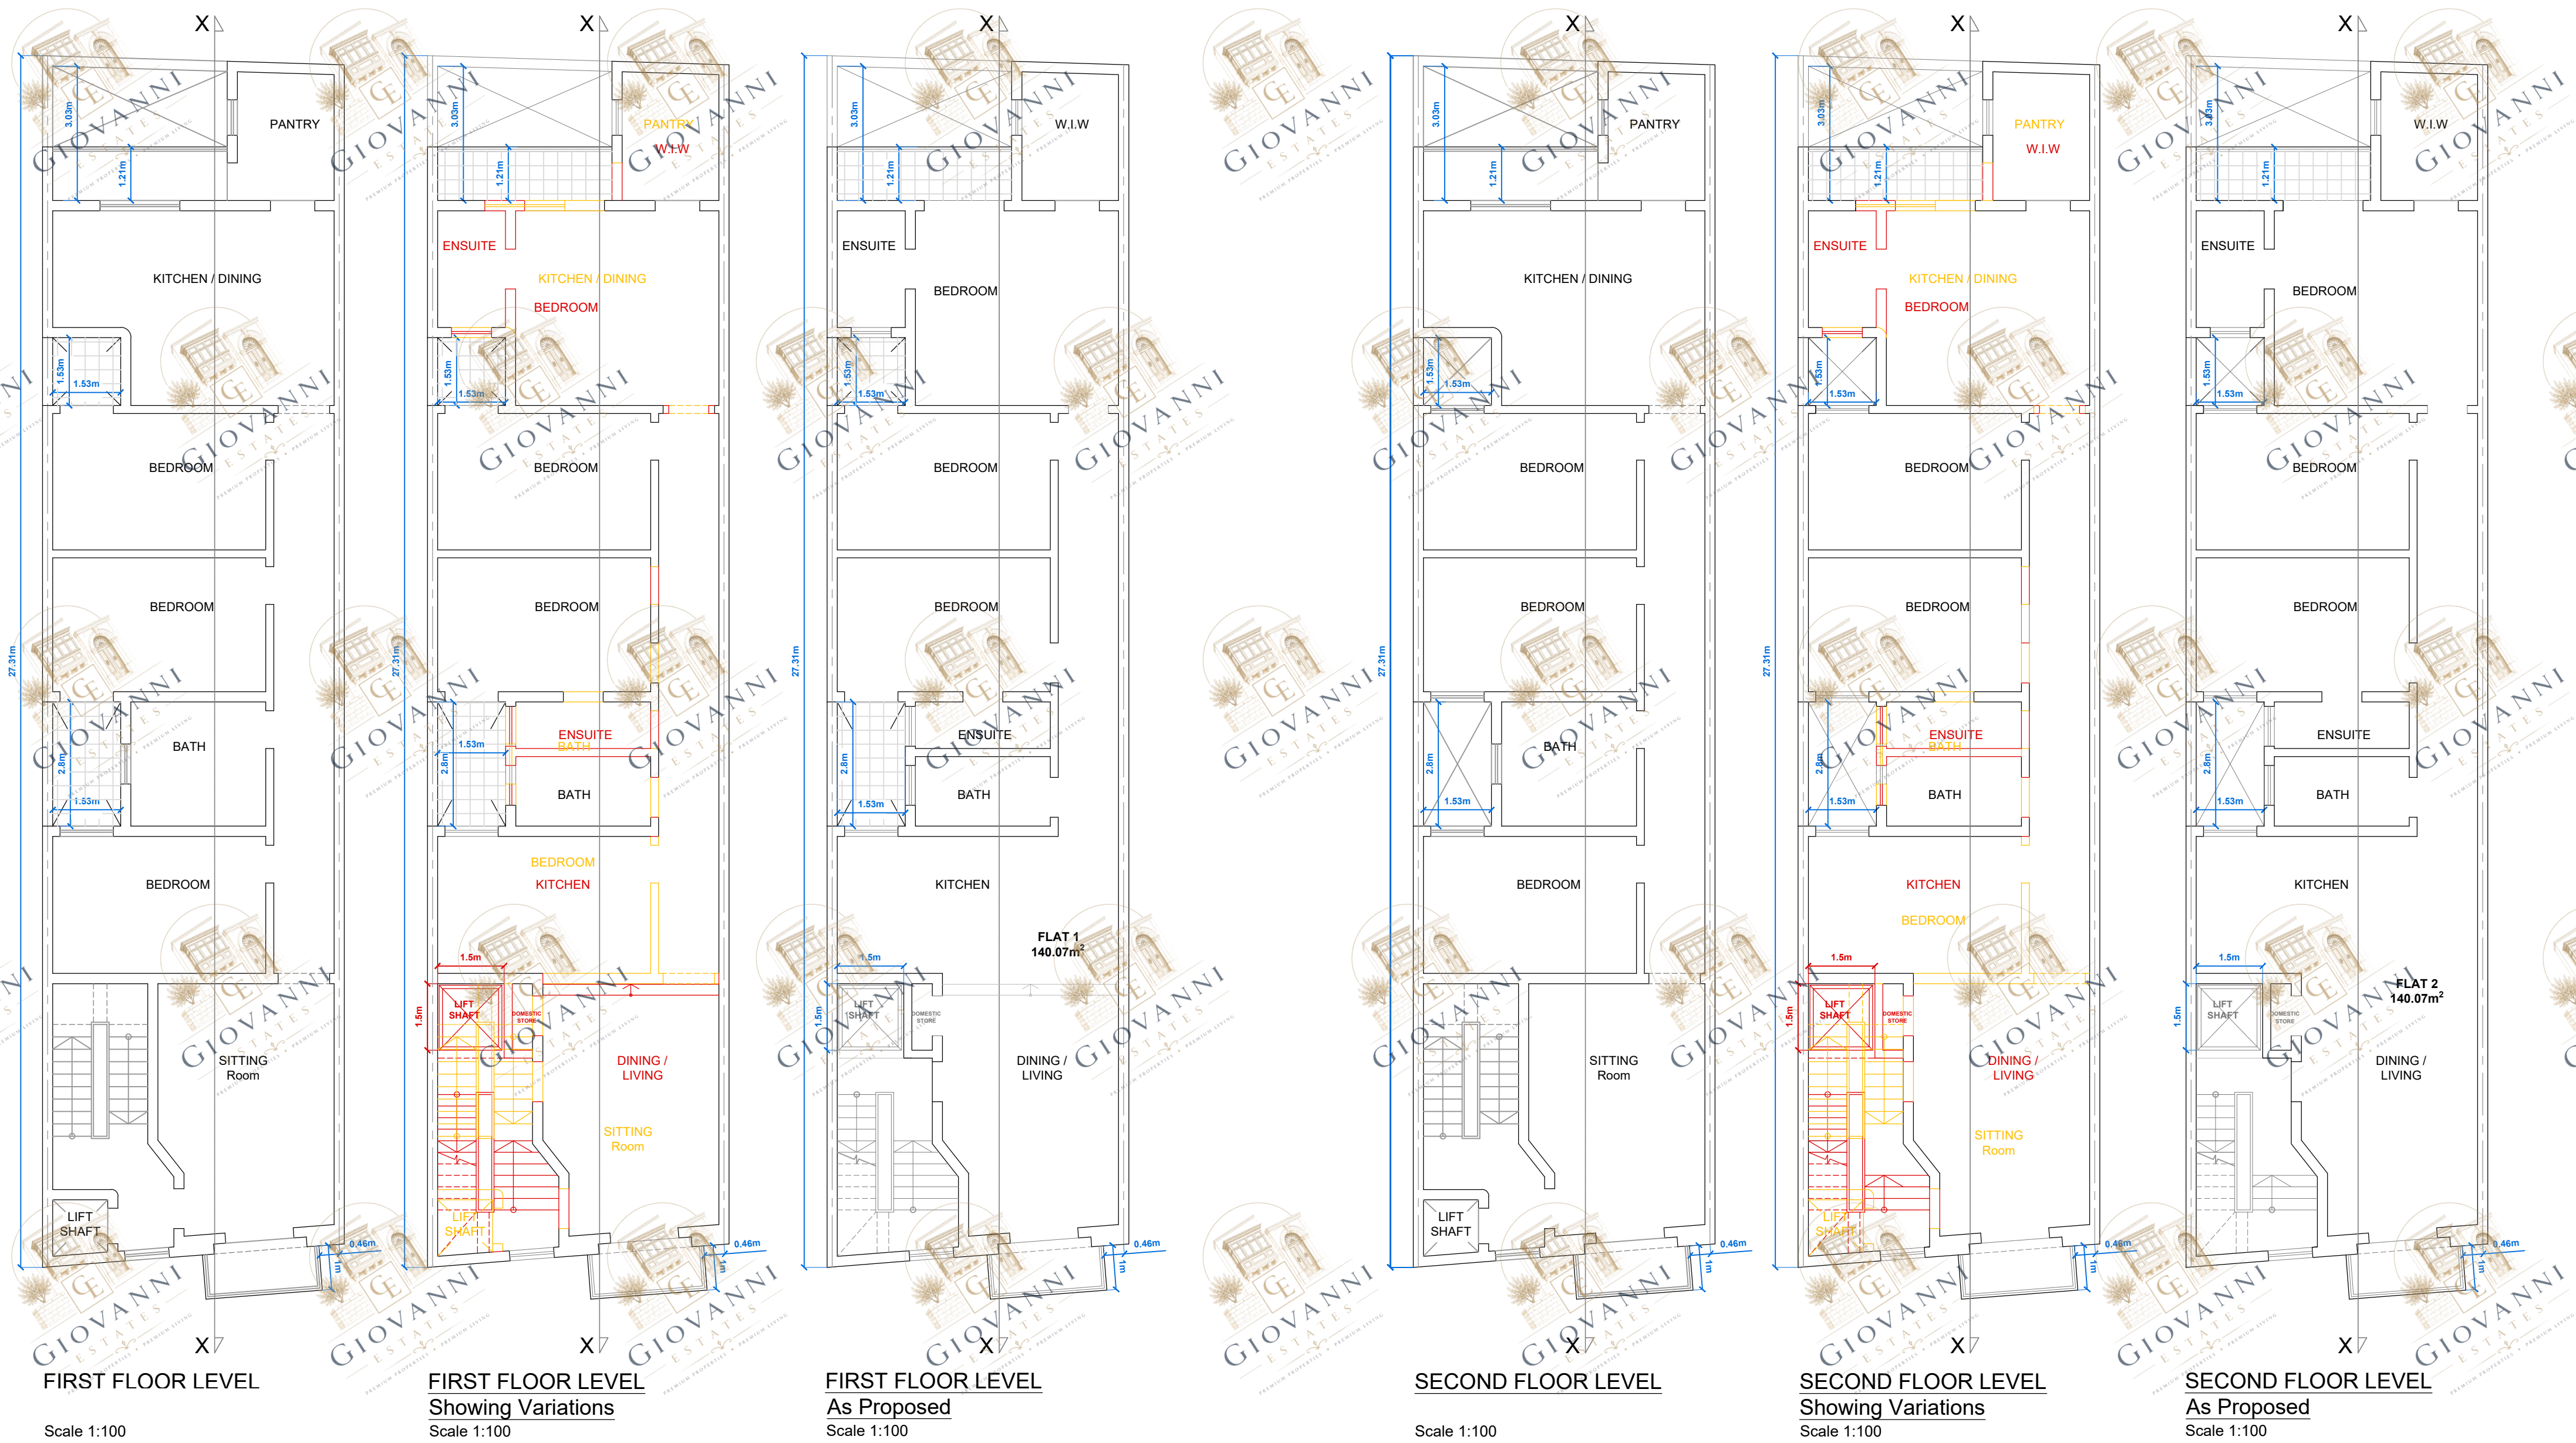

Note

1. Drawings are based on survey data and may not accurately represent what is physically present.
2. Do not scale from this drawing. All dimensions to be site verified by the contractor before proceeding.
3. All dimensions are in millimetres unless noted otherwise.
4. The project architect shall be notified in writing of any discrepancies.

Copyright

All rights to the drawings and designs are held by Vella + Grech Periti. Reproducing, sharing, or storing any part of this content, either in 2D or 3D format, by any method – including digital, photocopying, or other mechanical processes – without written consent from the copyright holder is strictly prohibited.

The content cannot be saved in any digital storage system without the copyright holder's written agreement. The rights and identification of the original creator for these designs are reserved.

The drawings and designs were produced by the copyright holder under an exclusive agreement for a specific client. Use of this content is restricted to this client based on the license's terms. Any permissions granted by the copyright holder under this license cease once the license ends or if the licensee faces insolvency issues.

Vella + Grech Periti disclaims any liability for unauthorised or unlicensed use of the designs and for any actions based on them. Construction based on these designs is not allowed unless there's explicit written approval from the copyright holder.

Address:

Triq l-Arcisqof Pietru Pace
Victoria, Gozo

Contact:


info@vgperiti.com
+356 21 551 963

Scale




AS PROPOSED (TO DEMOLISH)
AS PROPOSED (TO CONSTRUCT)


Site Area: 183.1m²

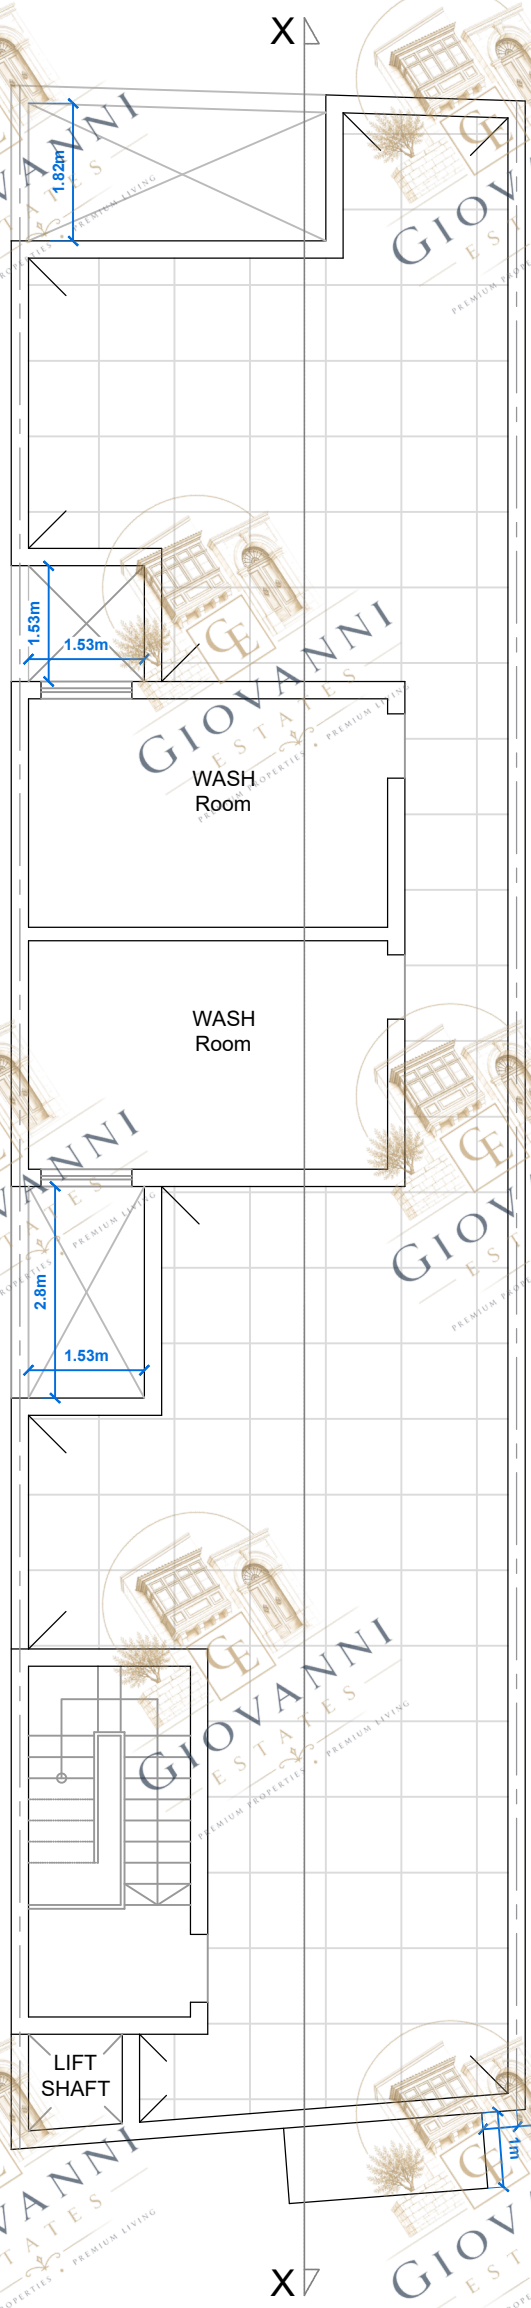


THIRD FLOOR LEVEL
As Existing
Scale 1:100

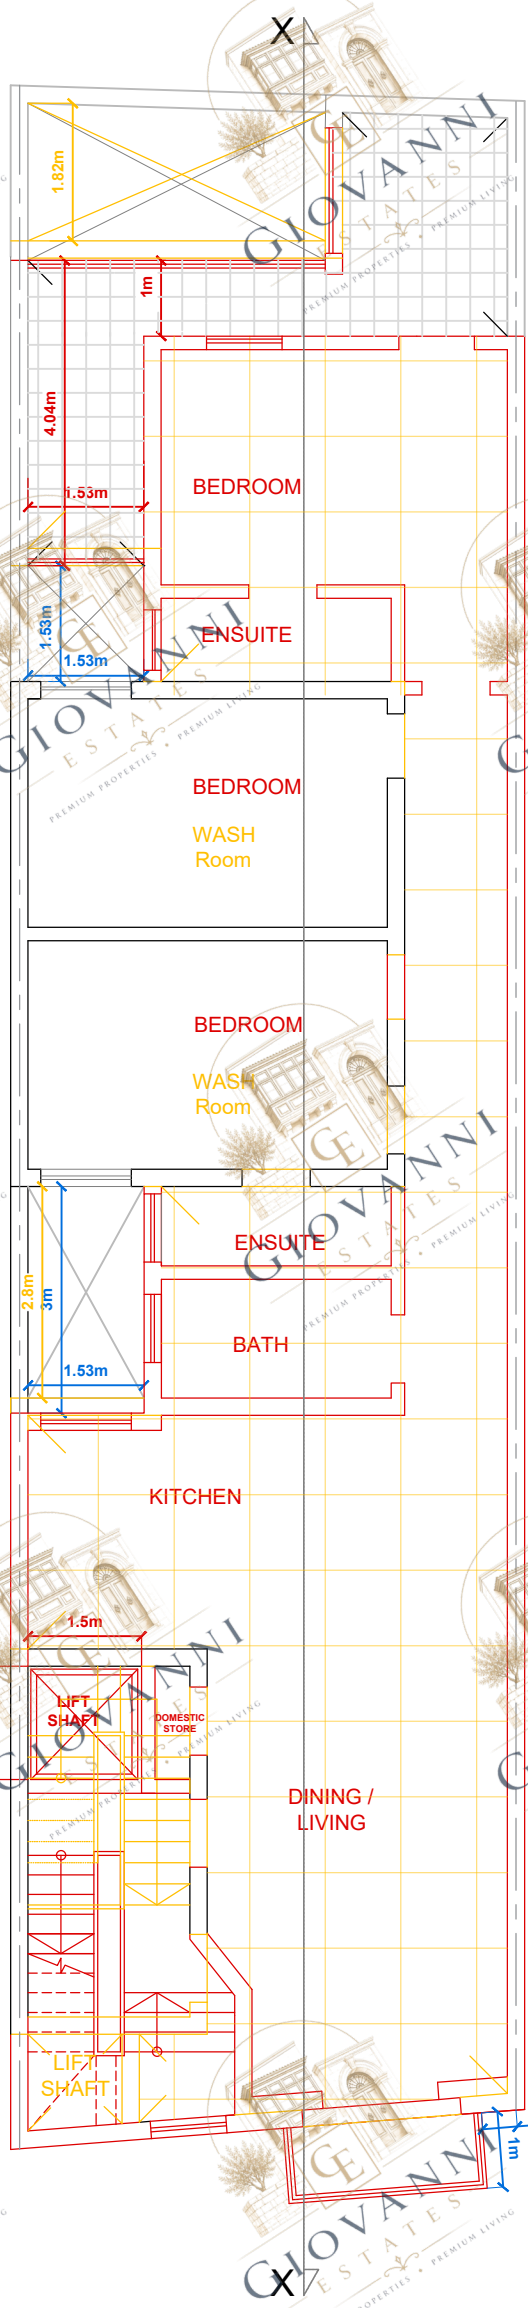


THIRD FLOOR LEVEL
Showing Variations
Scale 1:100

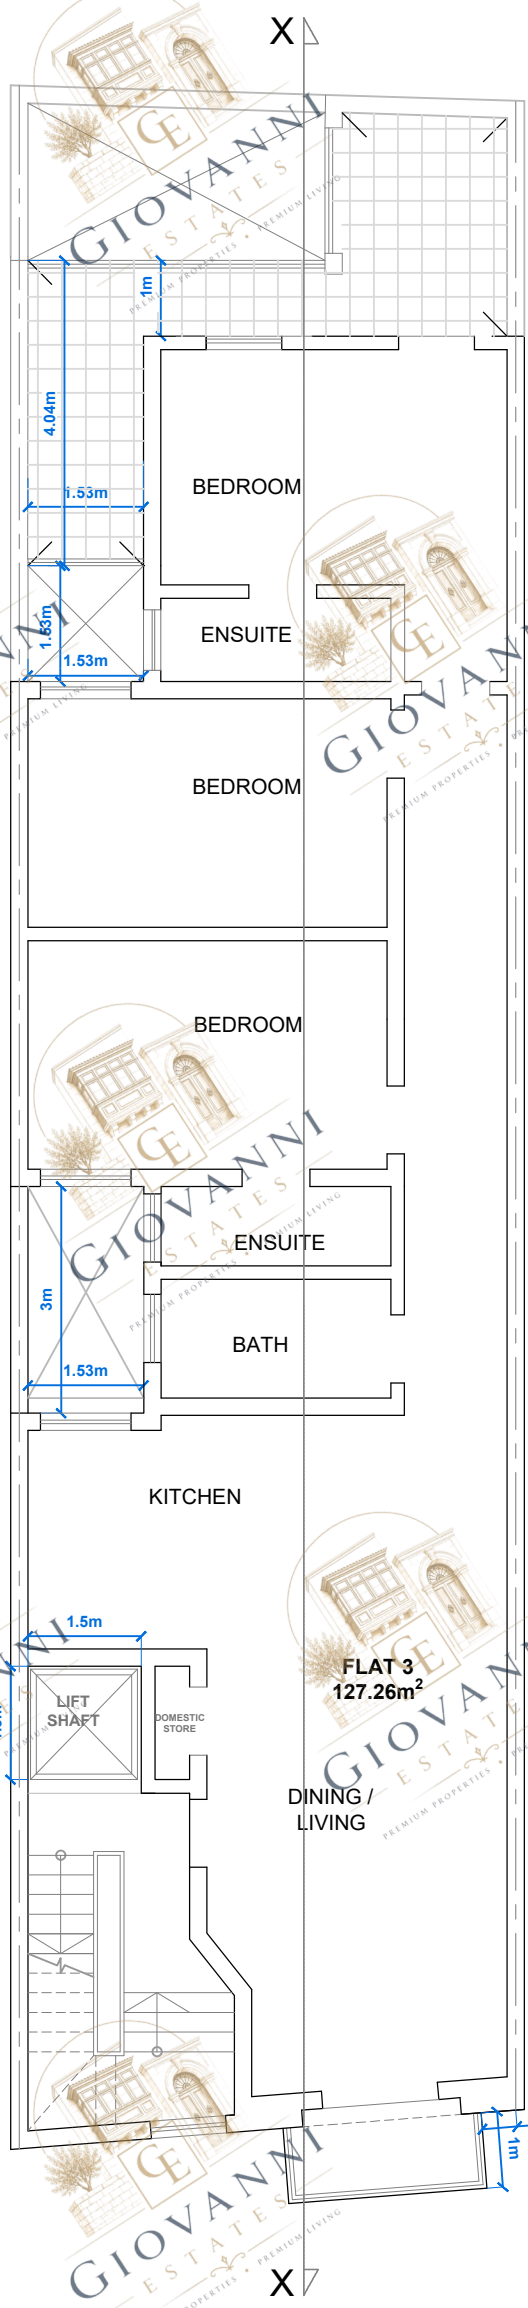

THIRD FLOOR LEVEL
As Proposed
Scale 1:100

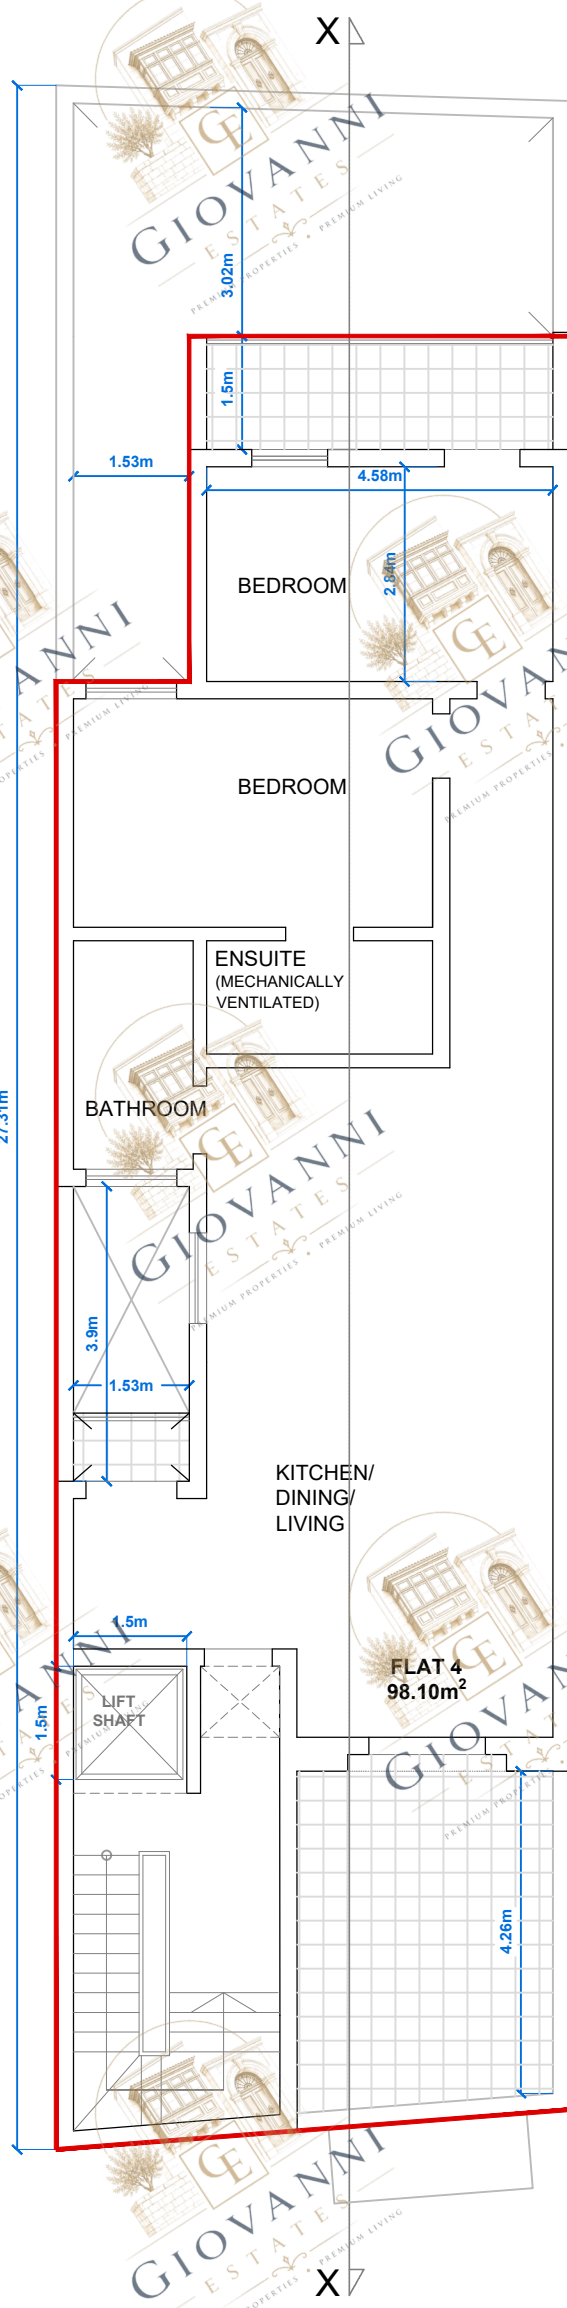

RECEDED FLOOR LEVEL
As Proposed
Scale 1:100

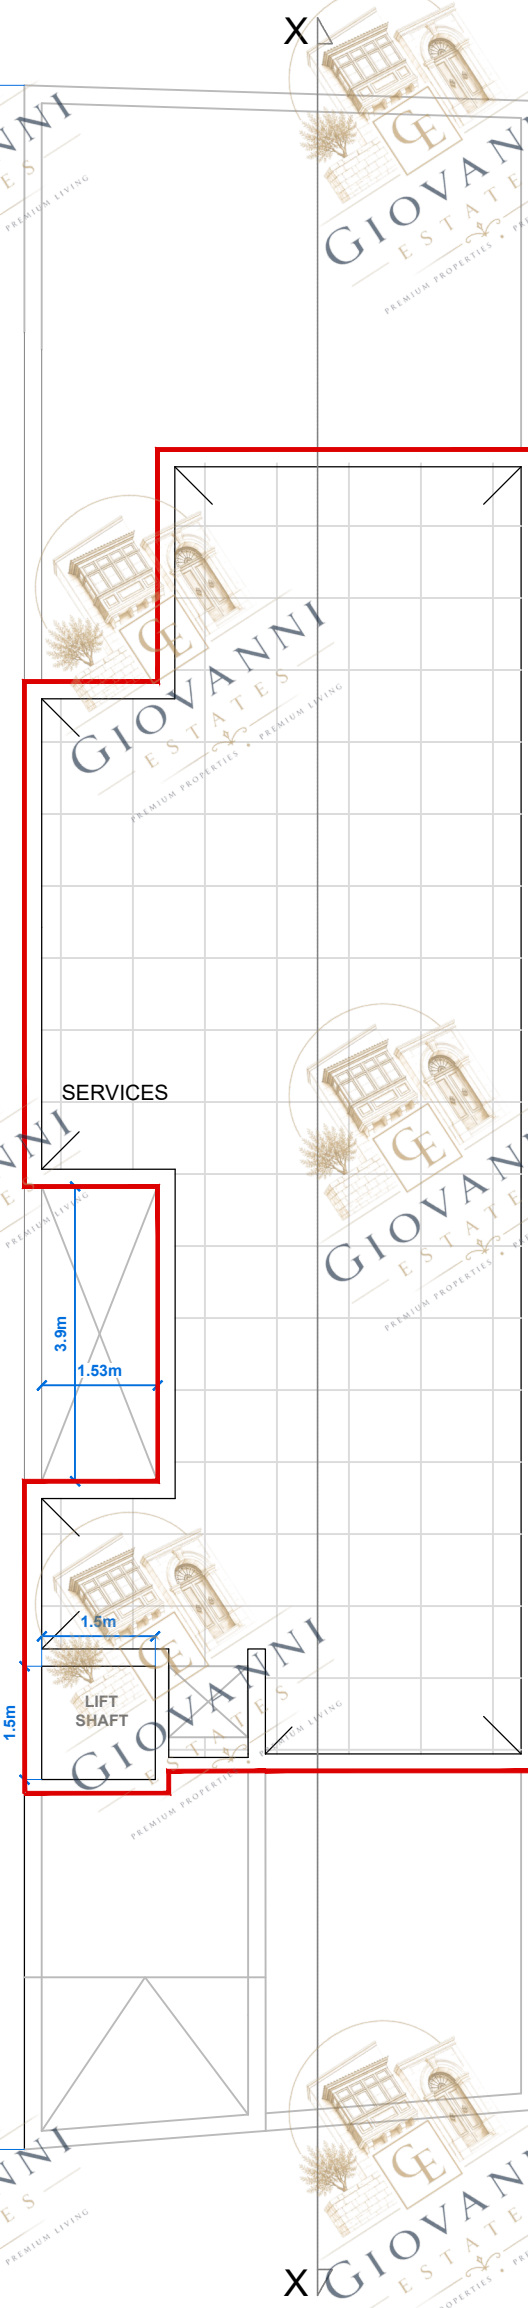

ROOF LEVEL
As Proposed
Scale 1:100

Note

1. Drawings are based on survey data and may not accurately represent what is physically present.
2. Do not scale from this drawing. All dimensions to be site verified by the contractor before proceeding.
3. All dimensions are in millimetres unless noted otherwise.
4. The project architect shall be notified in writing of any discrepancies.

Copyright

All rights to the drawings and designs are held by Vella + Grech Periti. Reproducing, sharing, or storing any part of this content, either in 2D or 3D format, by any method – including digital, photocopying, or other mechanical processes – without written consent from the copyright holder is strictly prohibited.

The content cannot be saved in any digital storage system without the copyright holder's written agreement. The rights and identification of the original creator for these designs are reserved.

The drawings and designs were produced by the copyright holder under an exclusive agreement for a specific client. Use of this content is restricted to this client based on the license's terms. Any permissions granted by the copyright holder under this license cease once the license ends or if the licensee faces insolvency issues.

Vella + Grech Periti disclaims any liability for unauthorised or unlicensed use of the designs and for any actions based on them. Construction based on these designs is not allowed unless there's explicit written approval from the copyright holder.

Address:

Triq l-Arcisqof Pietru Pace
Victoria, Gozo

Contact:

info@vgperiti.com
+356 21 551 963

Scale



AS PROPOSED (TO DEMOLISH)
AS PROPOSED (TO CONSTRUCT)


Site Area: 183.1m²



BASEMENT LEVEL


Scale 1:100

AS APPROVED
AS BUILT, TO SANCTION

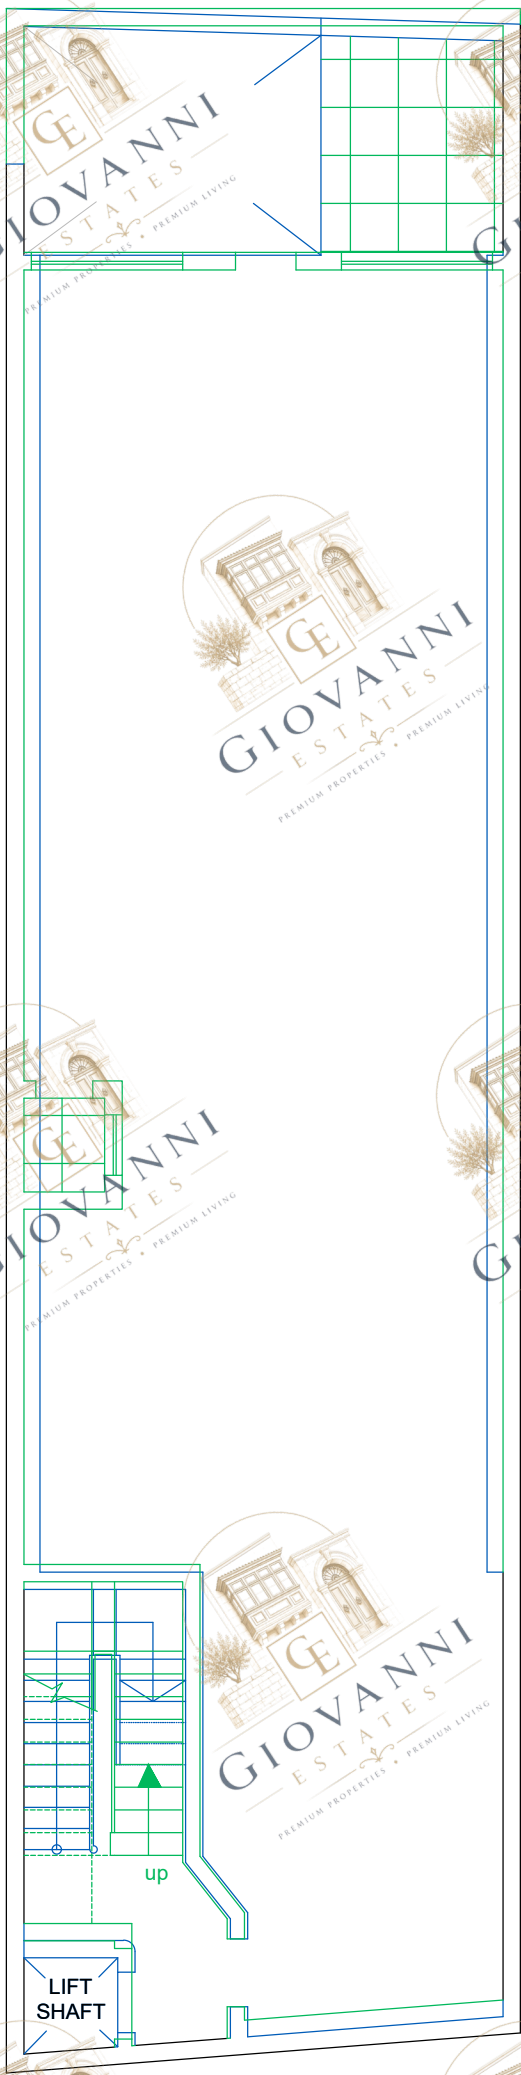


BASEMENT LEVEL

Showing Variations
Scale 1:100

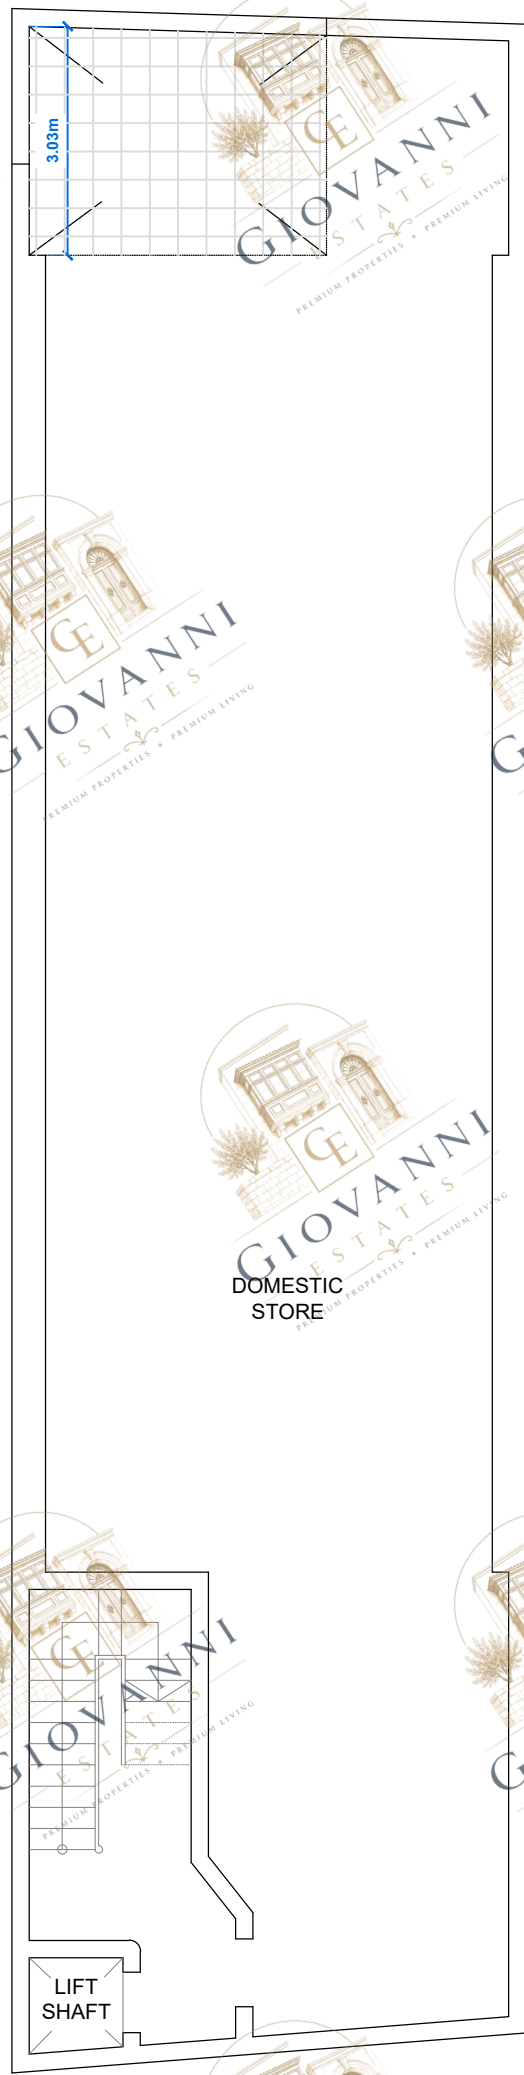


BASEMENT LEVEL

As Existing
Scale 1:100

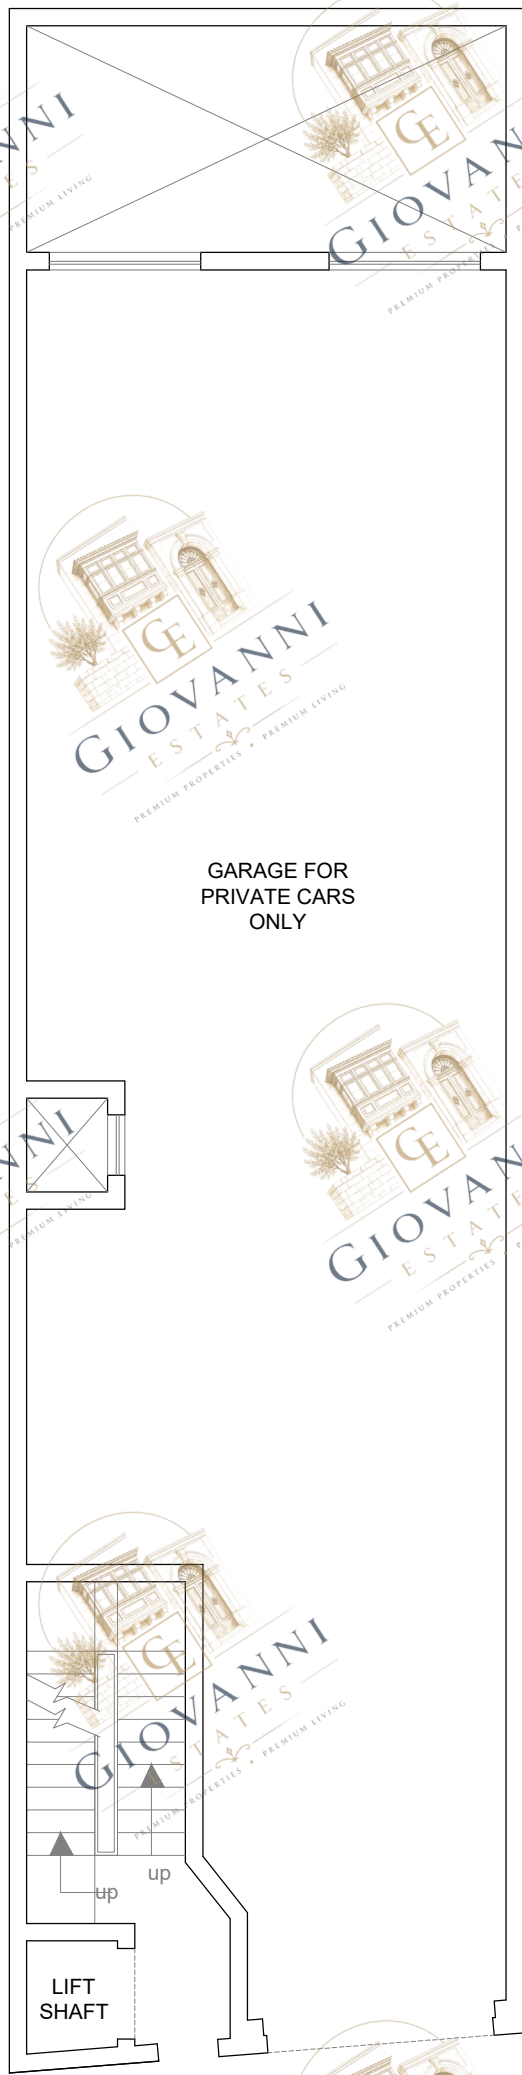

GROUND FLOOR PLAN

Scale 1:100

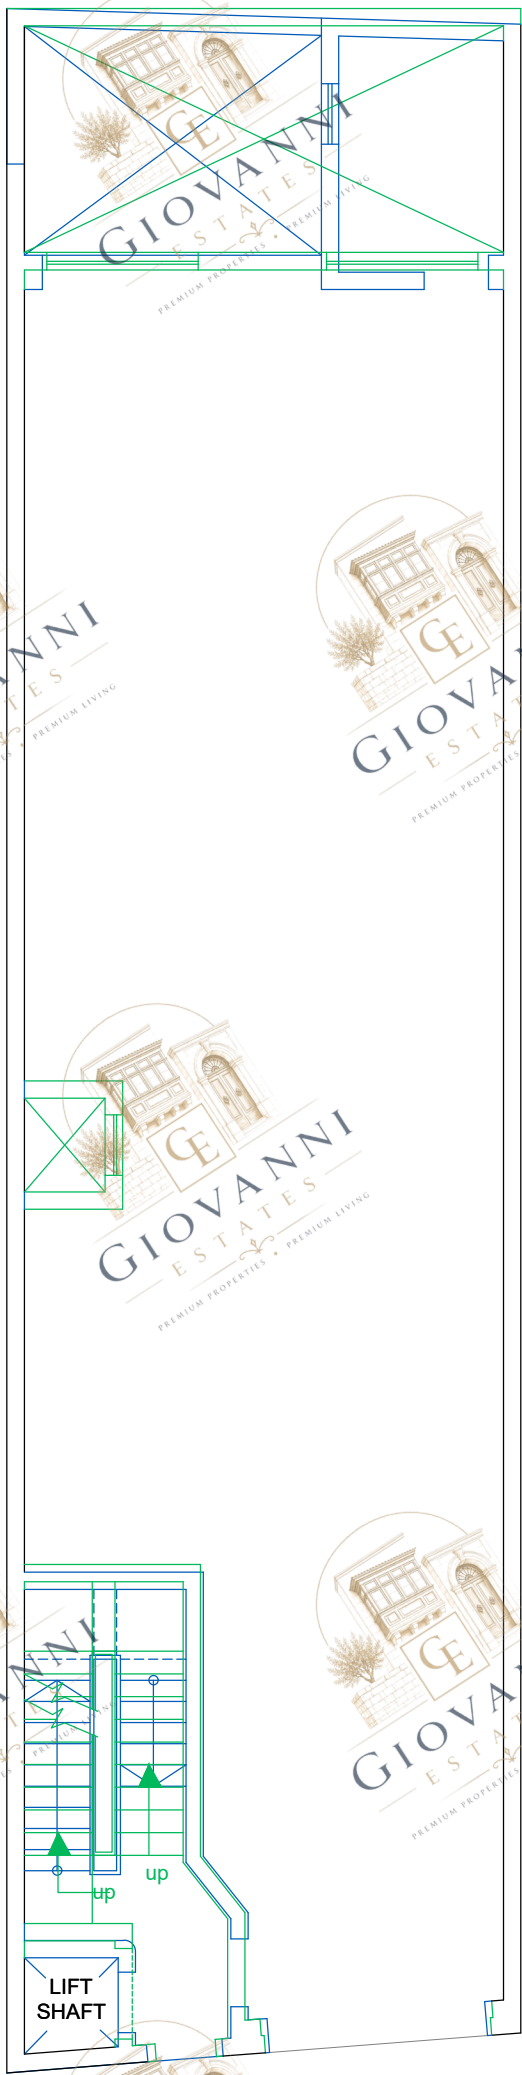

GROUND FLOOR LEVEL

Showing Variations
Scale 1:100



GROUND FLOOR LEVEL

As Existing
Scale 1:100

Note

1. Drawings are based on survey data and may not accurately represent what is physically present.
2. Do not scale from this drawing. All dimensions to be site verified by the contractor before proceeding.
3. All dimensions are in millimetres unless noted otherwise.
4. The project architect shall be notified in writing of any discrepancies.

Copyright

All rights to the drawings and designs are held by Vella + Grech Periti. Reproducing, sharing, or storing any part of this content, either in 2D or 3D format, by any method – including digital, photocopying, or other mechanical processes – without written consent from the copyright holder is strictly prohibited.

The content cannot be saved in any digital storage system without the copyright holder's written agreement. The rights and identification of the original creator for these designs are reserved.

The drawings and designs were produced by the copyright holder under an exclusive agreement for a specific client. Use of this content is restricted to this client based on the license's terms. Any permissions granted by the copyright holder under this license cease once the license ends or if the licensee faces insolvency issues.

Vella + Grech Periti disclaims any liability for unauthorised or unlicensed use of the designs and for any actions based on them. Construction based on these designs is not allowed unless there's explicit written approval from the copyright holder.

Address:

Triq l-Arcisqof Pietru Pace
Victoria, Gozo

Contact:

info@vgperiti.com
+356 21 551 963

Scale

