




APPROVED GROUND FLOOR IN PA02388/17
scale 1:100



GROUND FLOOR AS BUILT
scale 1:100

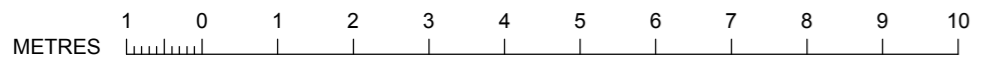

SCALE 1:100




APPROVED FRONT ELEVATION
scale 1:100




FRONT ELEVATION AS BUILT
scale 1:100

Ta' Annna
Block A

Ta' Karmnu
Block B

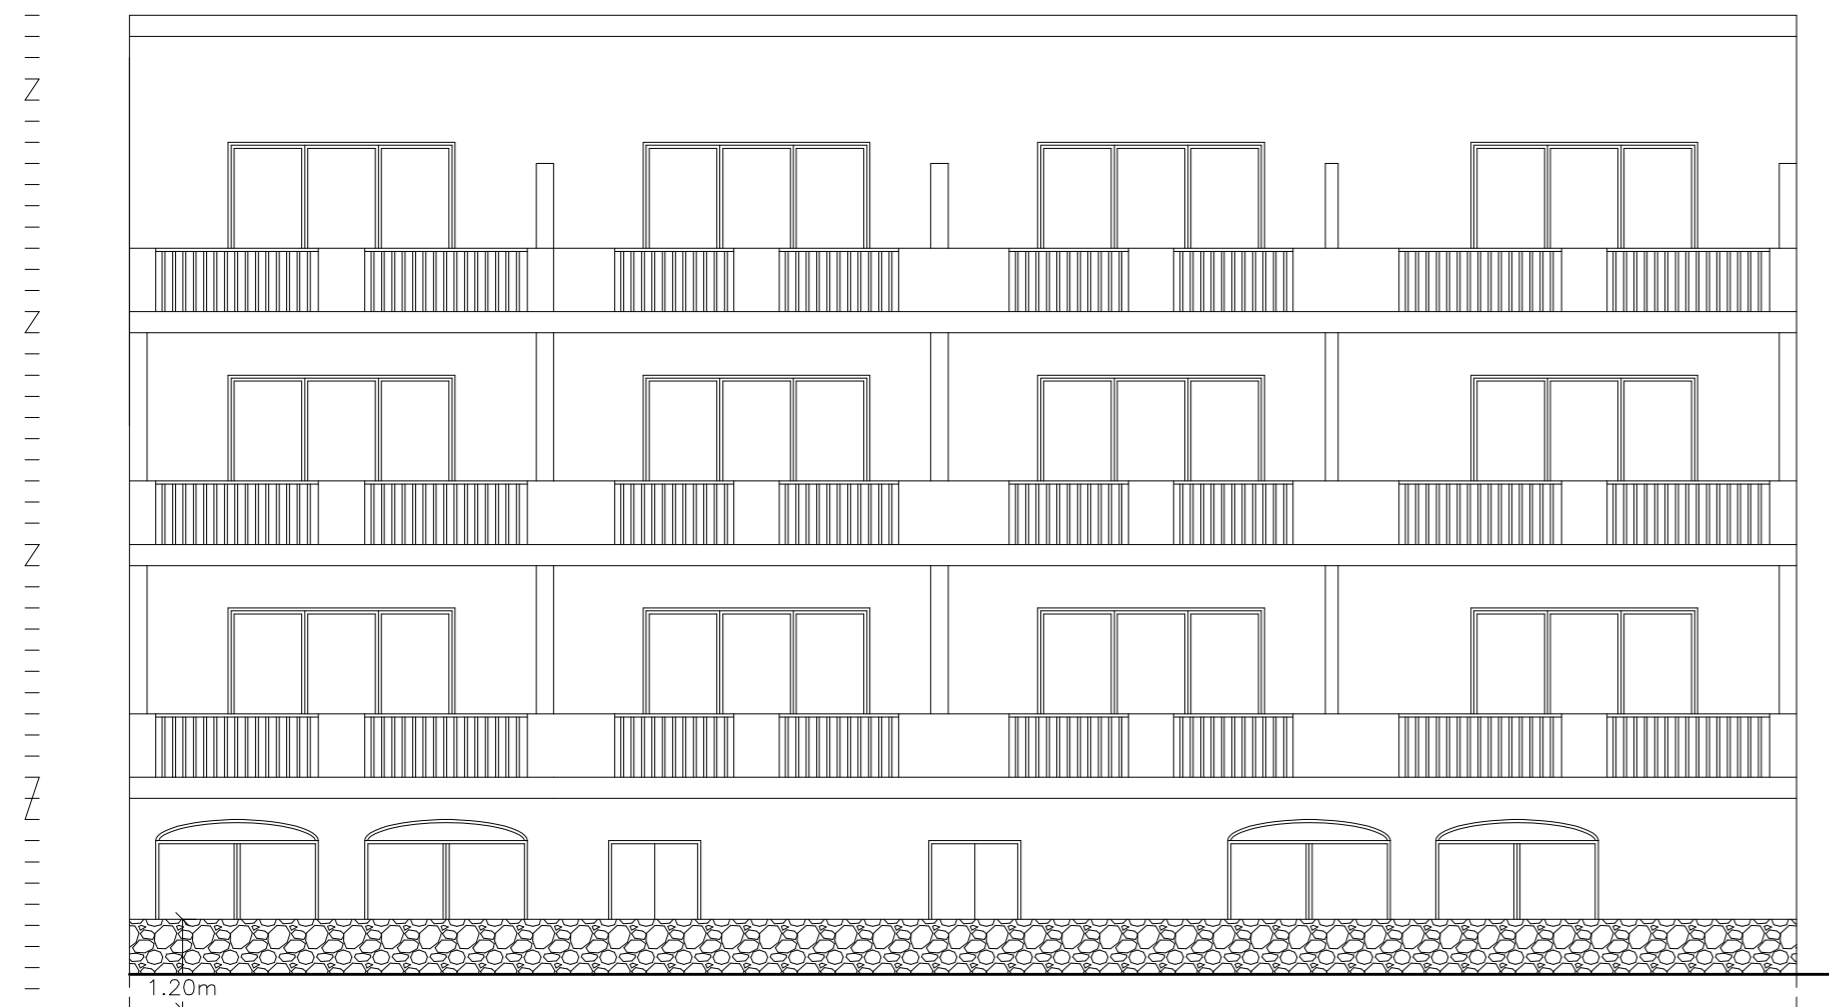


APPROVED BACK ELEVATION
scale 1:100

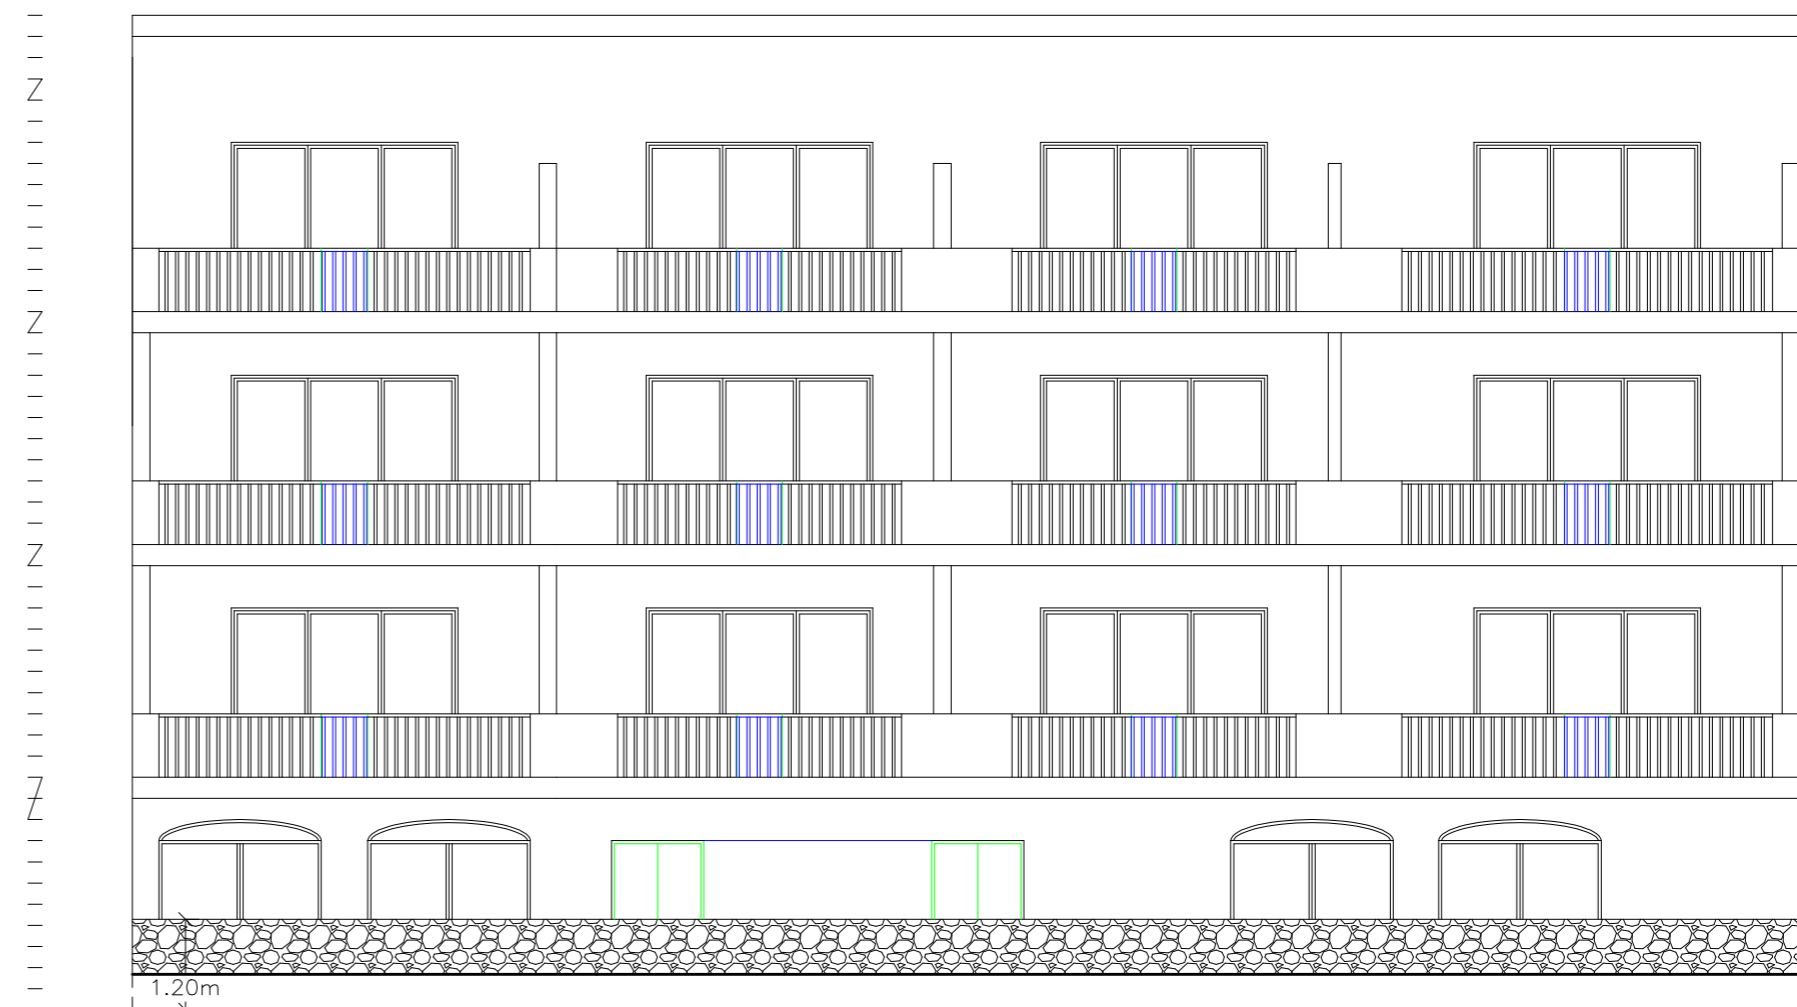

BACK ELEVATION AS BUILT
scale 1:100

FACADE MATERIALS:
franka masonry unpainted;
aluminium apertures and railings;
franka masonry balustrades

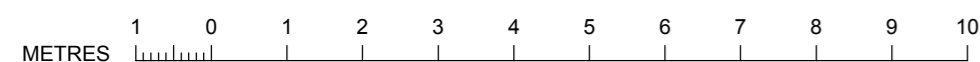

SCALE 1:100