




Second Floor Plan
(as approved in PA3138/01)
Scale 1:100

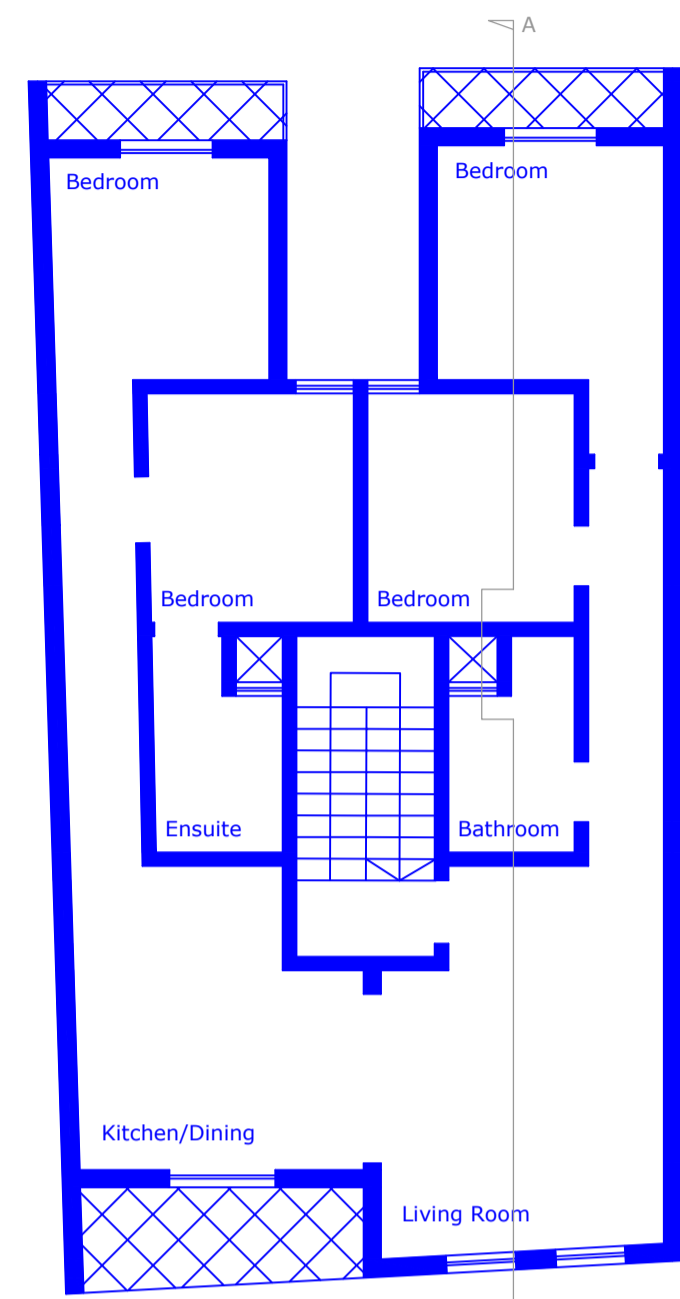


Second Floor Plan as built
(to sanction)
Scale 1:100

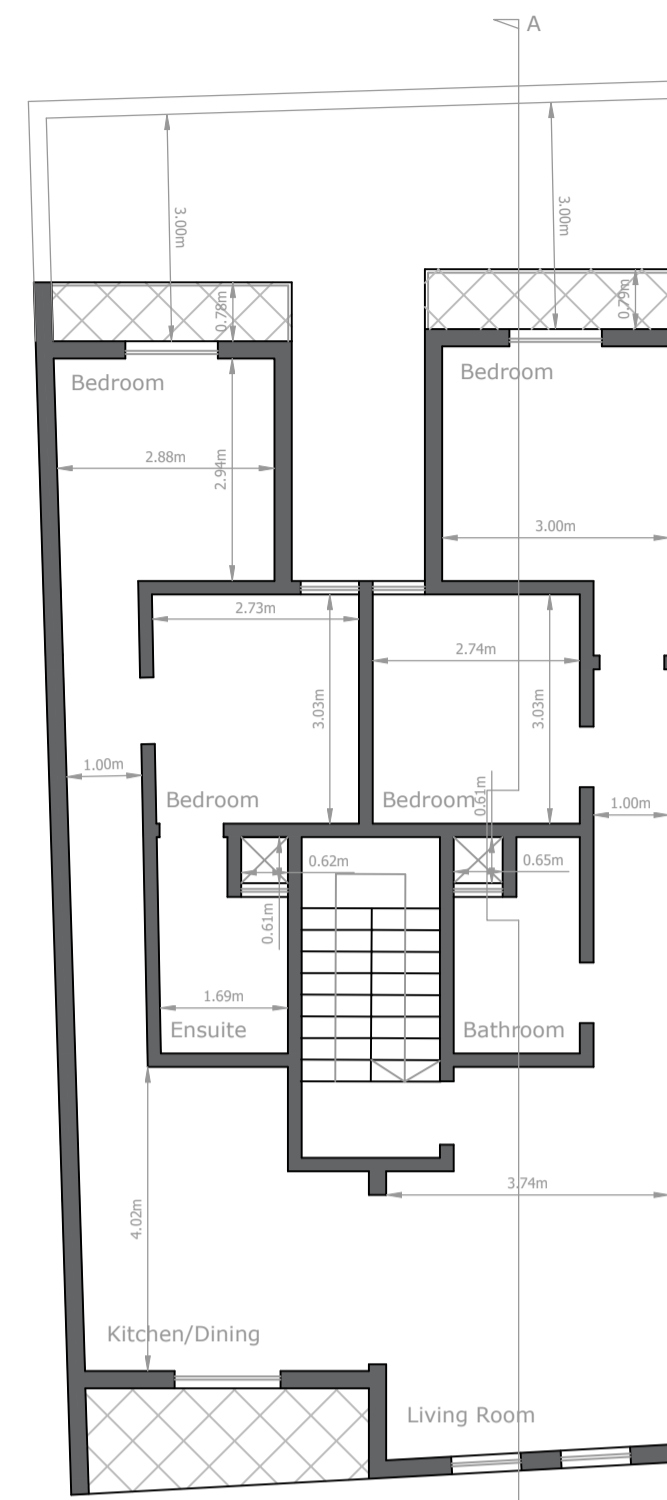


Second Floor Plan as built
(clean copy)
Gross Floor Area = 117.8sqm
Scale 1:100

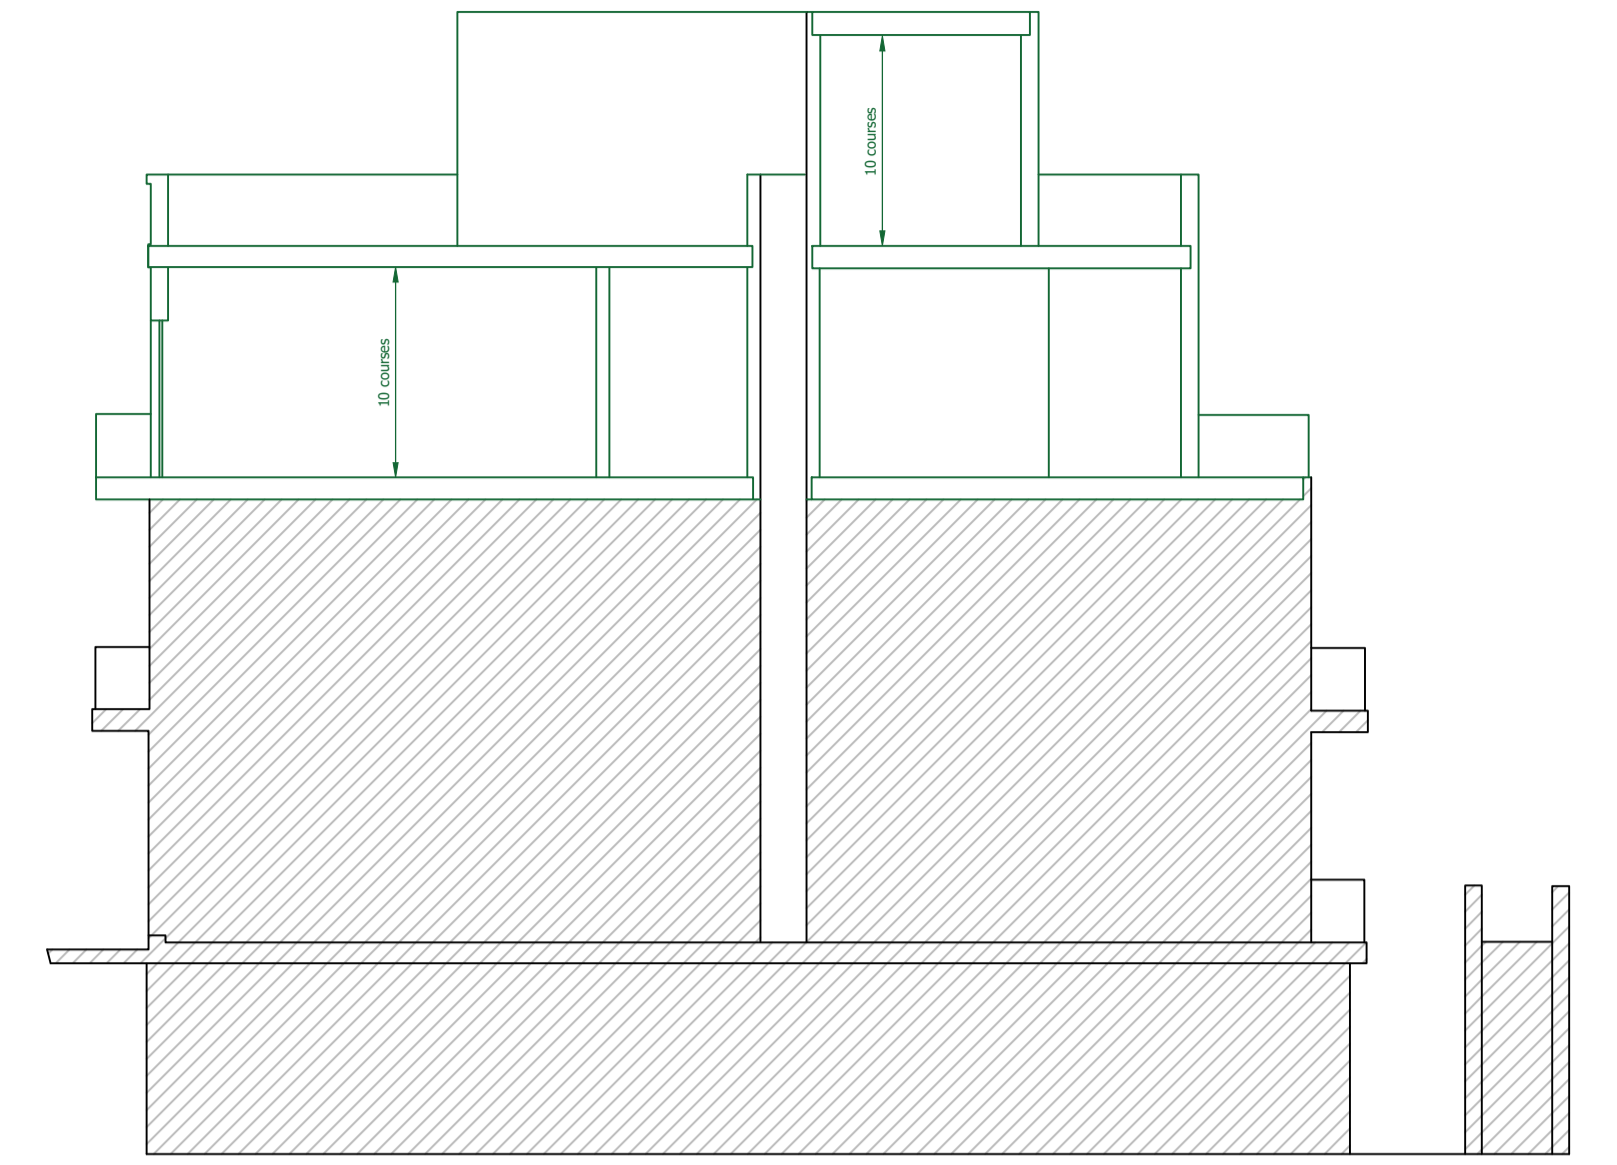


Longitudinal Section A-A
(as approved in PA3138/01)
Scale 1:100

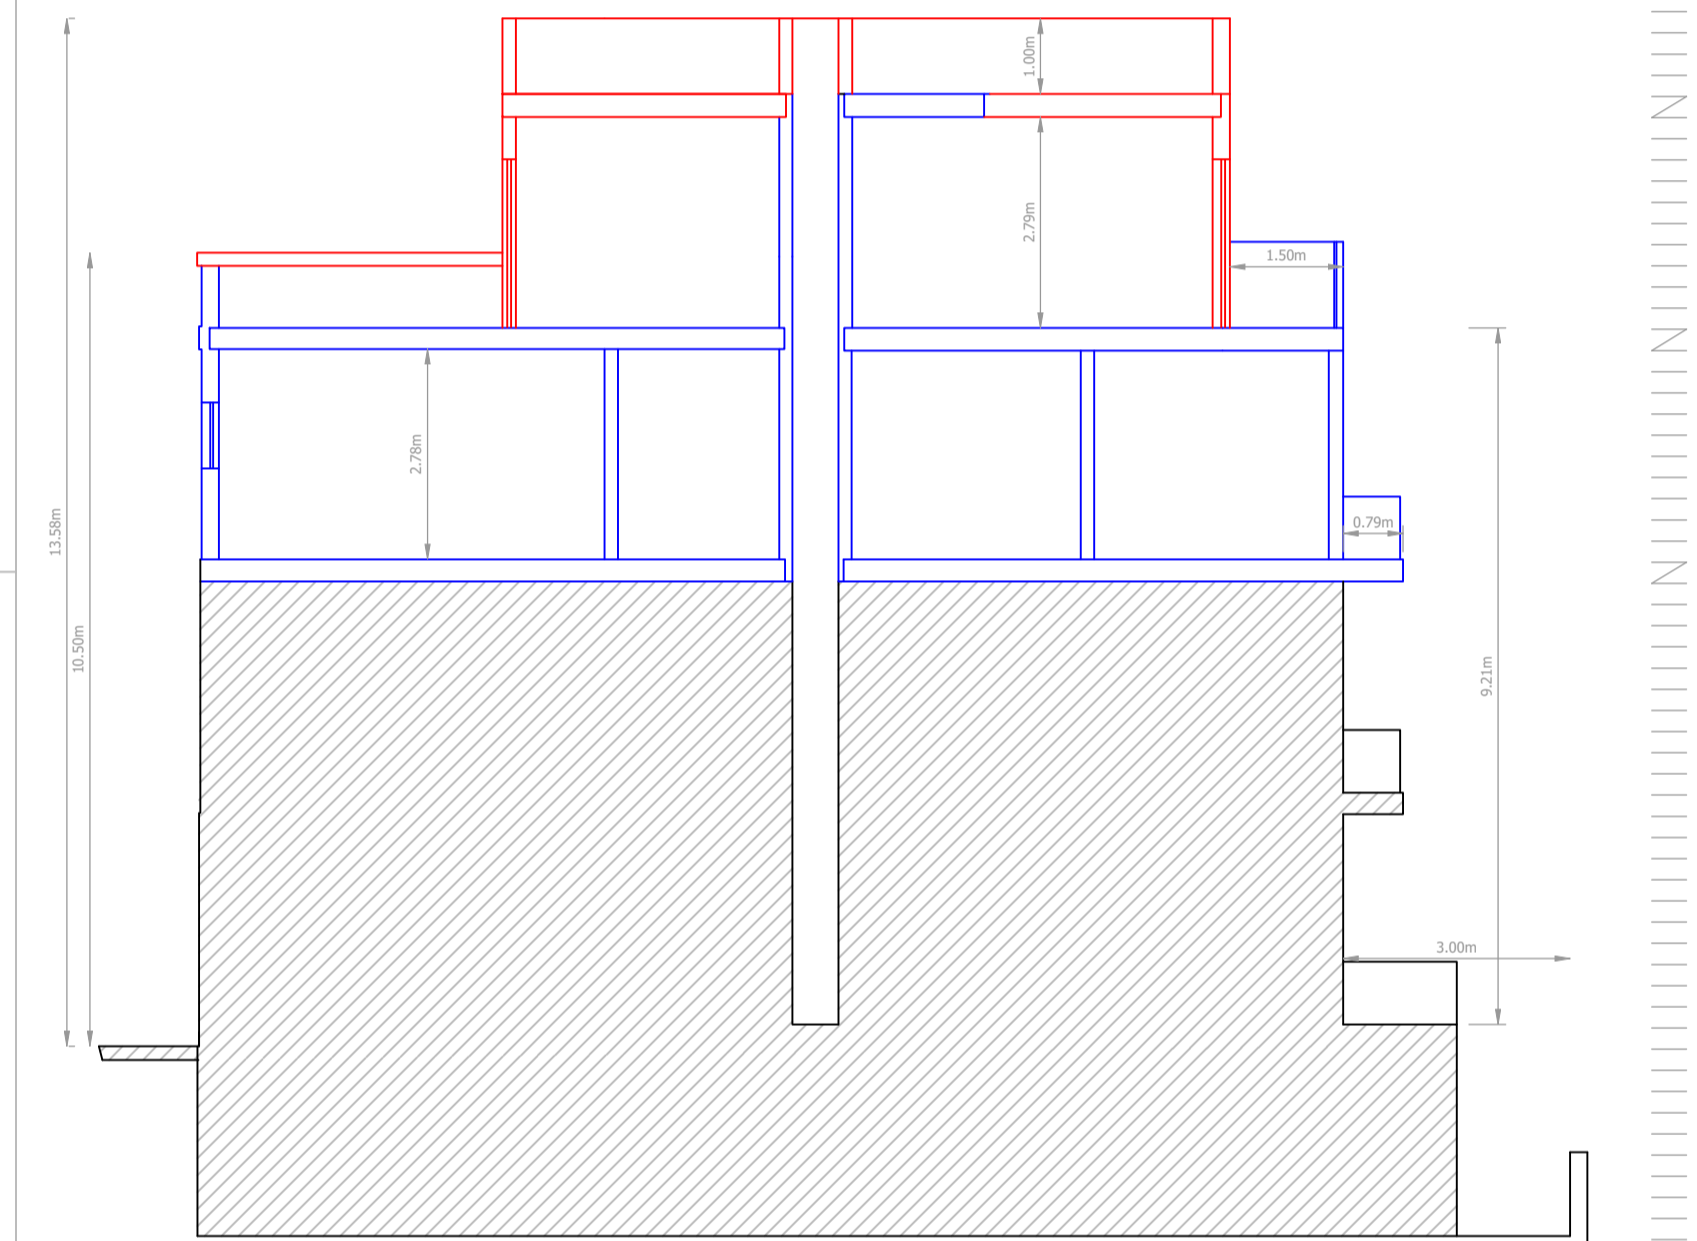


Existing and Proposed Longitudinal
Section A-A
Scale 1:100

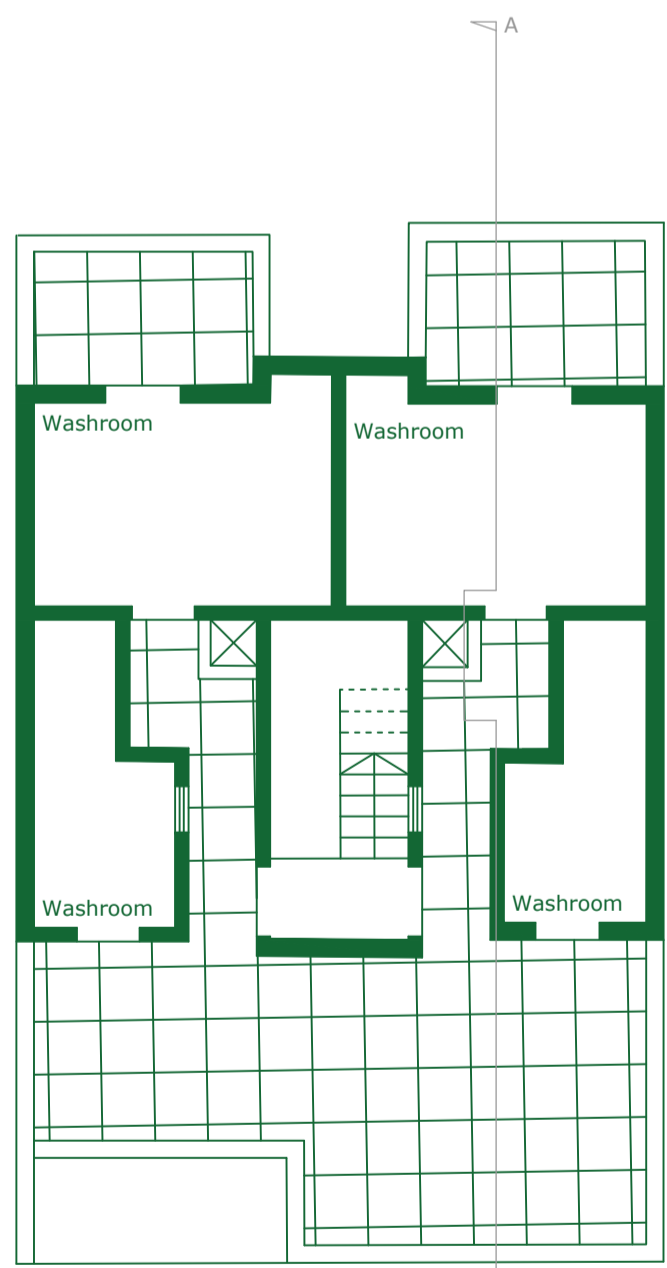


Roof (Third Floor) Plan
(as approved in PA3138/01)
Scale 1:100

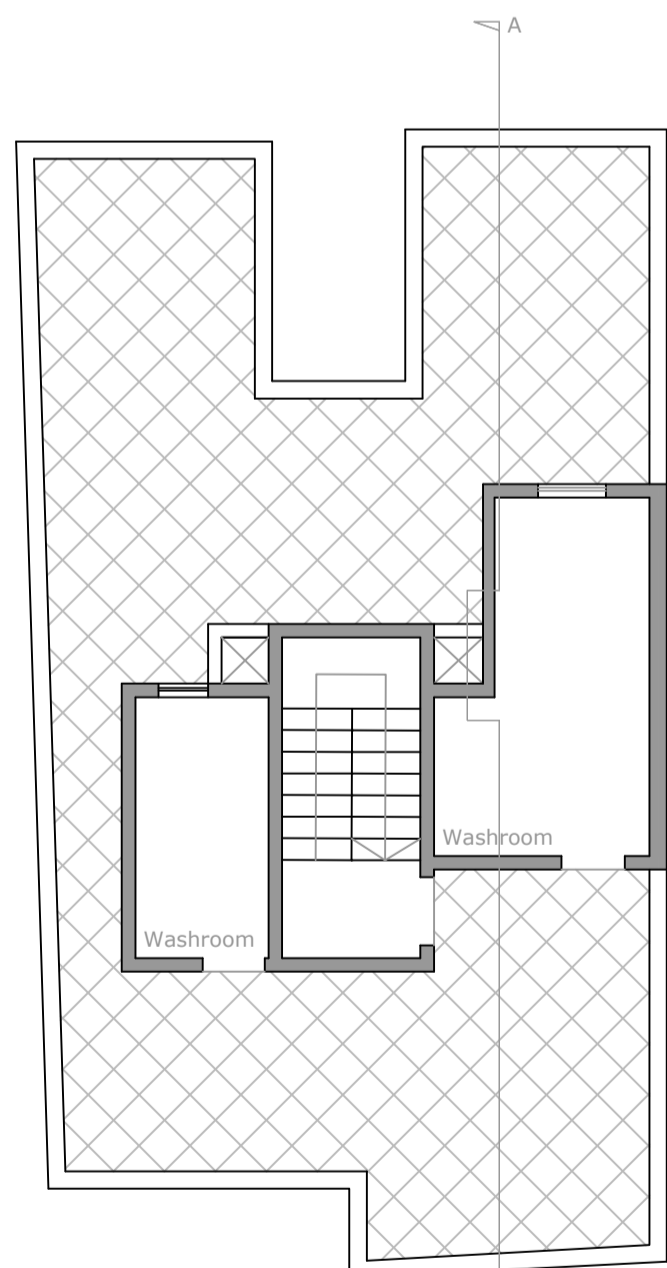


Roof (Third Floor) Plan as built
Scale 1:100

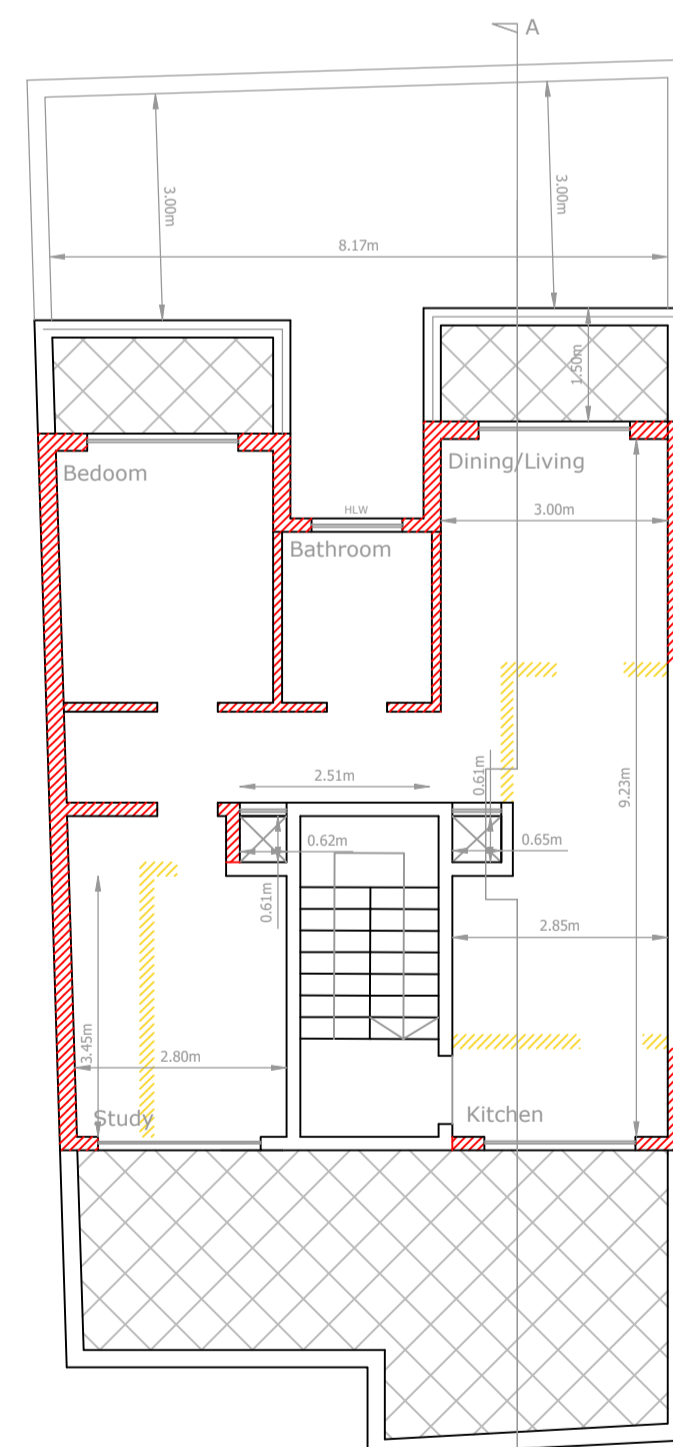


Third Floor Plan
(as proposed, with colour coding)
Scale 1:100

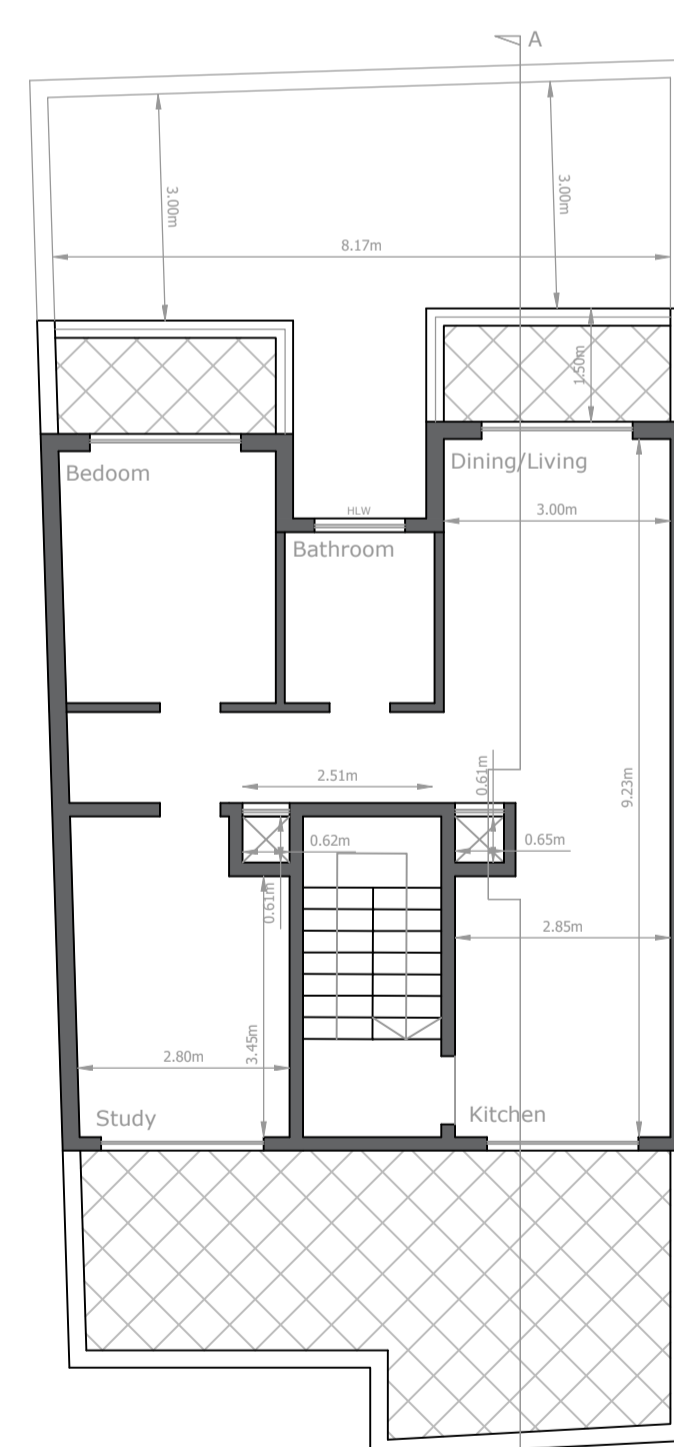

Third Floor Plan
(as proposed, clean copy)
Gross Floor Area = 78.7sqm
Scale 1:100

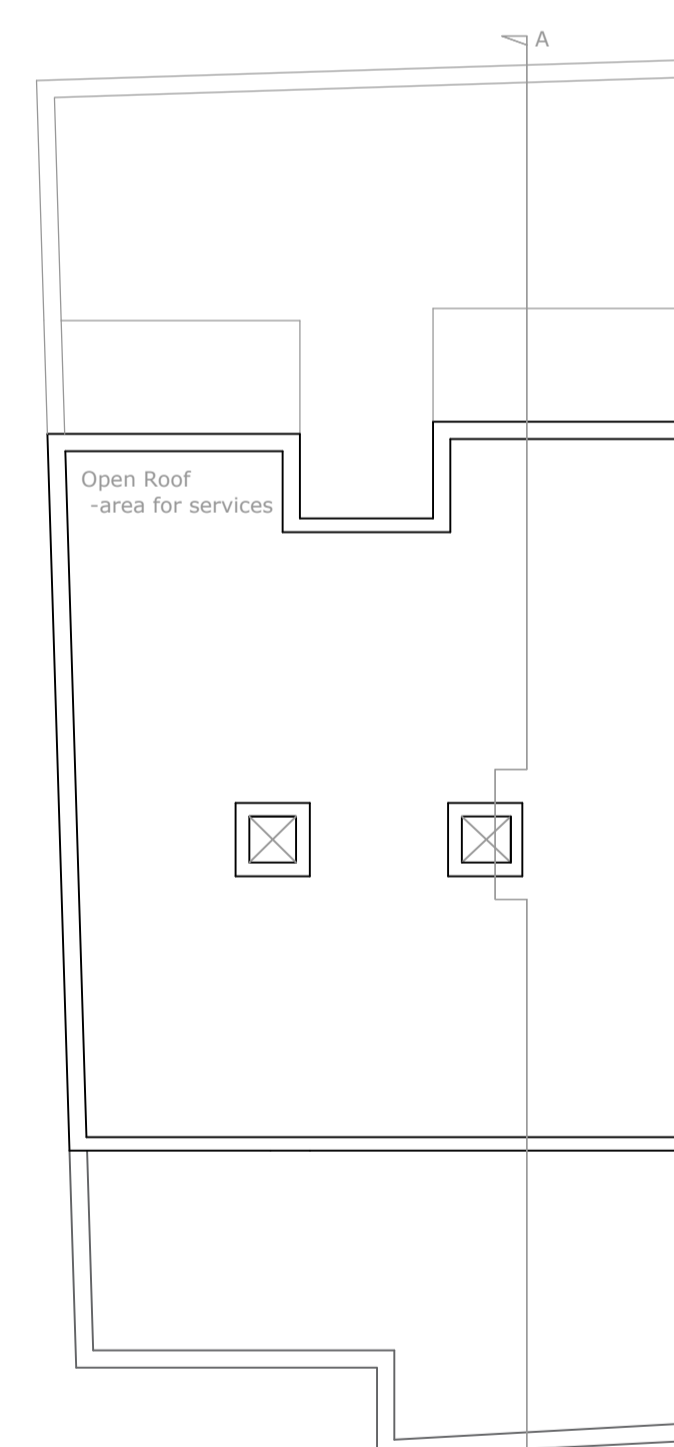


Roof Plan
(as proposed)
Scale 1:100

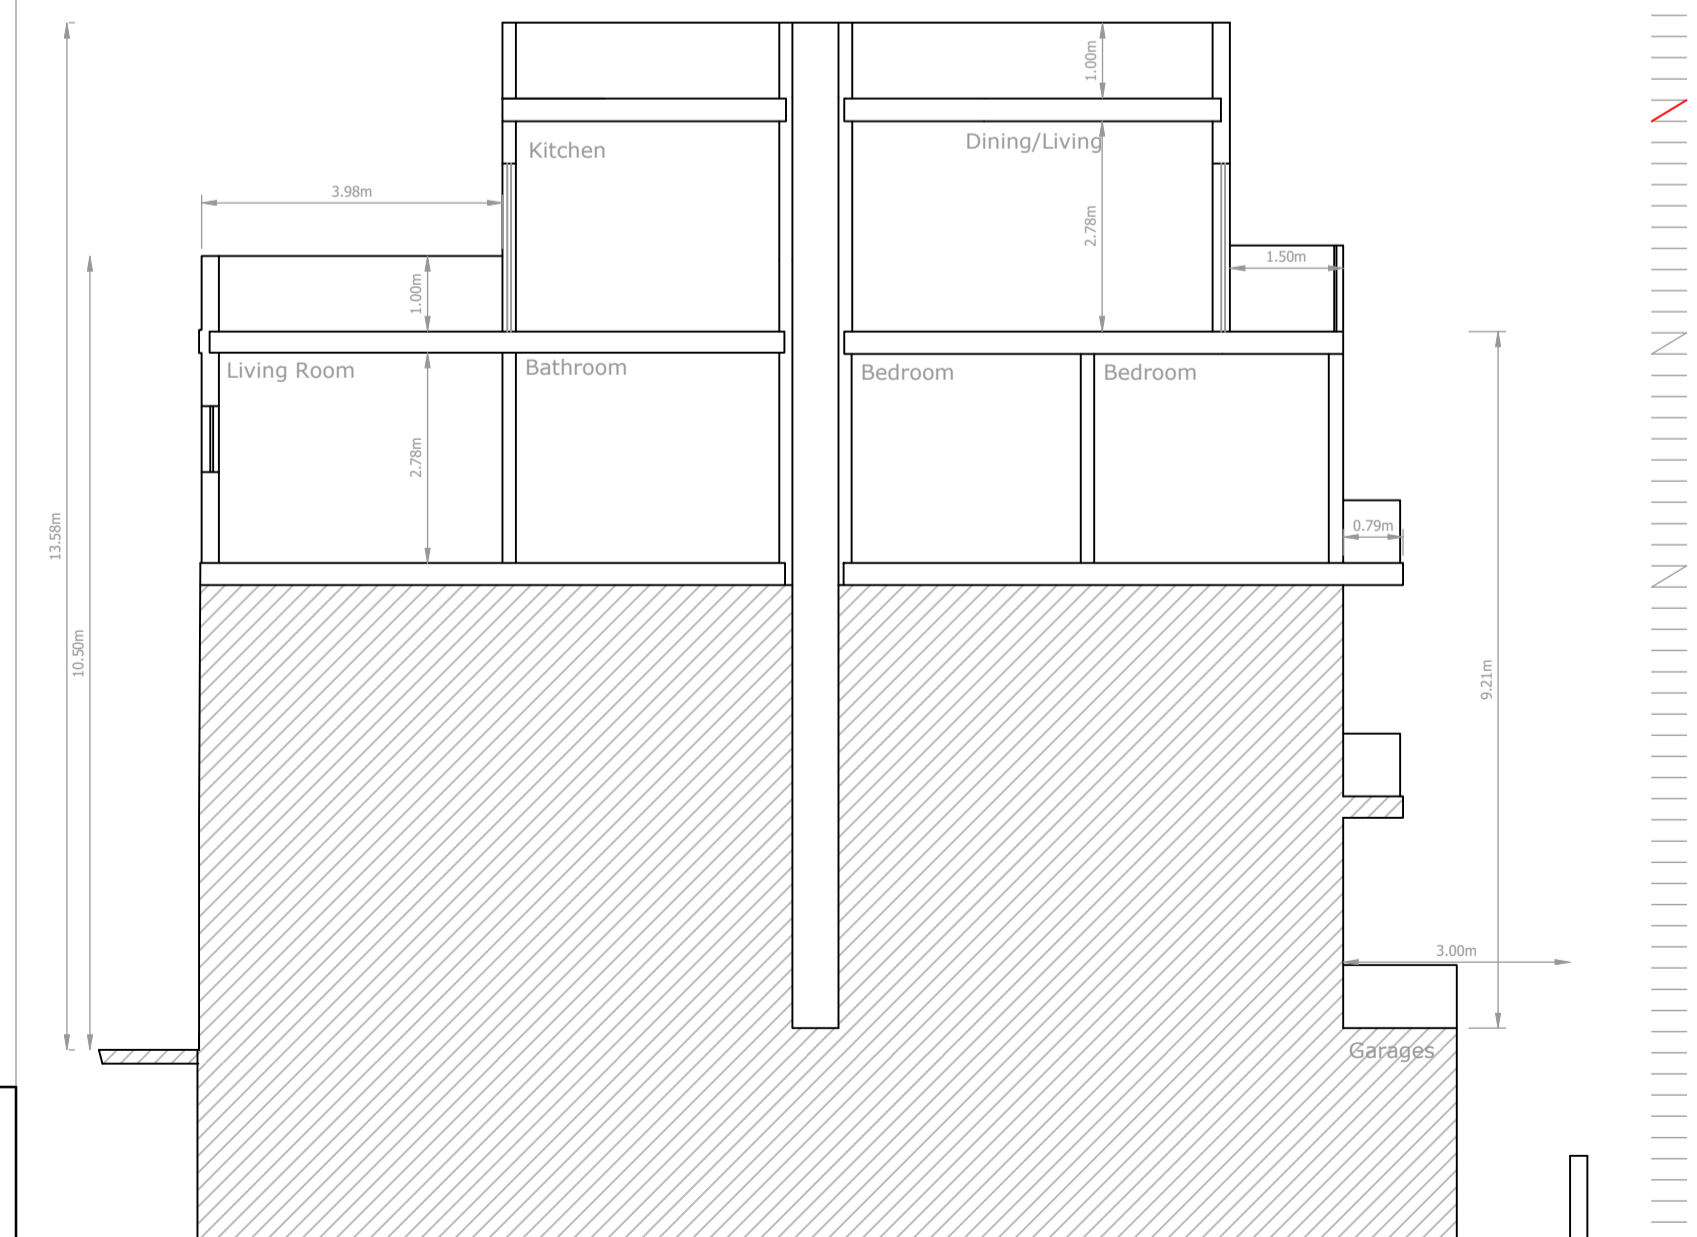

Proposed Longitudinal Section A-A
(clean copy)
Scale 1:100

Note
 blue — as constructed, to sanction
 green — approved but not constructed, to sanction
 yellow — proposed demolition
 red — proposed construction

SCALE 1:100

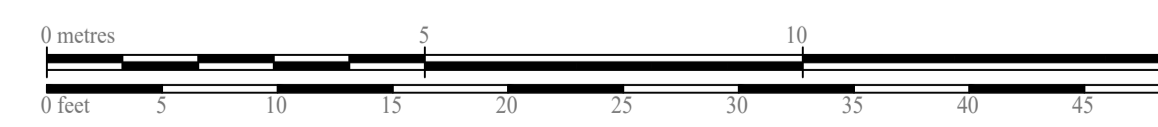

Materials on Facade:
 Franka Stone Facade
 Brown aluminium apertures
 Brown aluminium railings



Existing Elevation
 Scale 1:50



Proposed Elevation
 Scale 1:50

Note

- blue – as constructed, to sanction
- green – approved but not constructed, to sanction
- yellow – proposed demolition
- red – proposed construction

SCALE 1:50

