

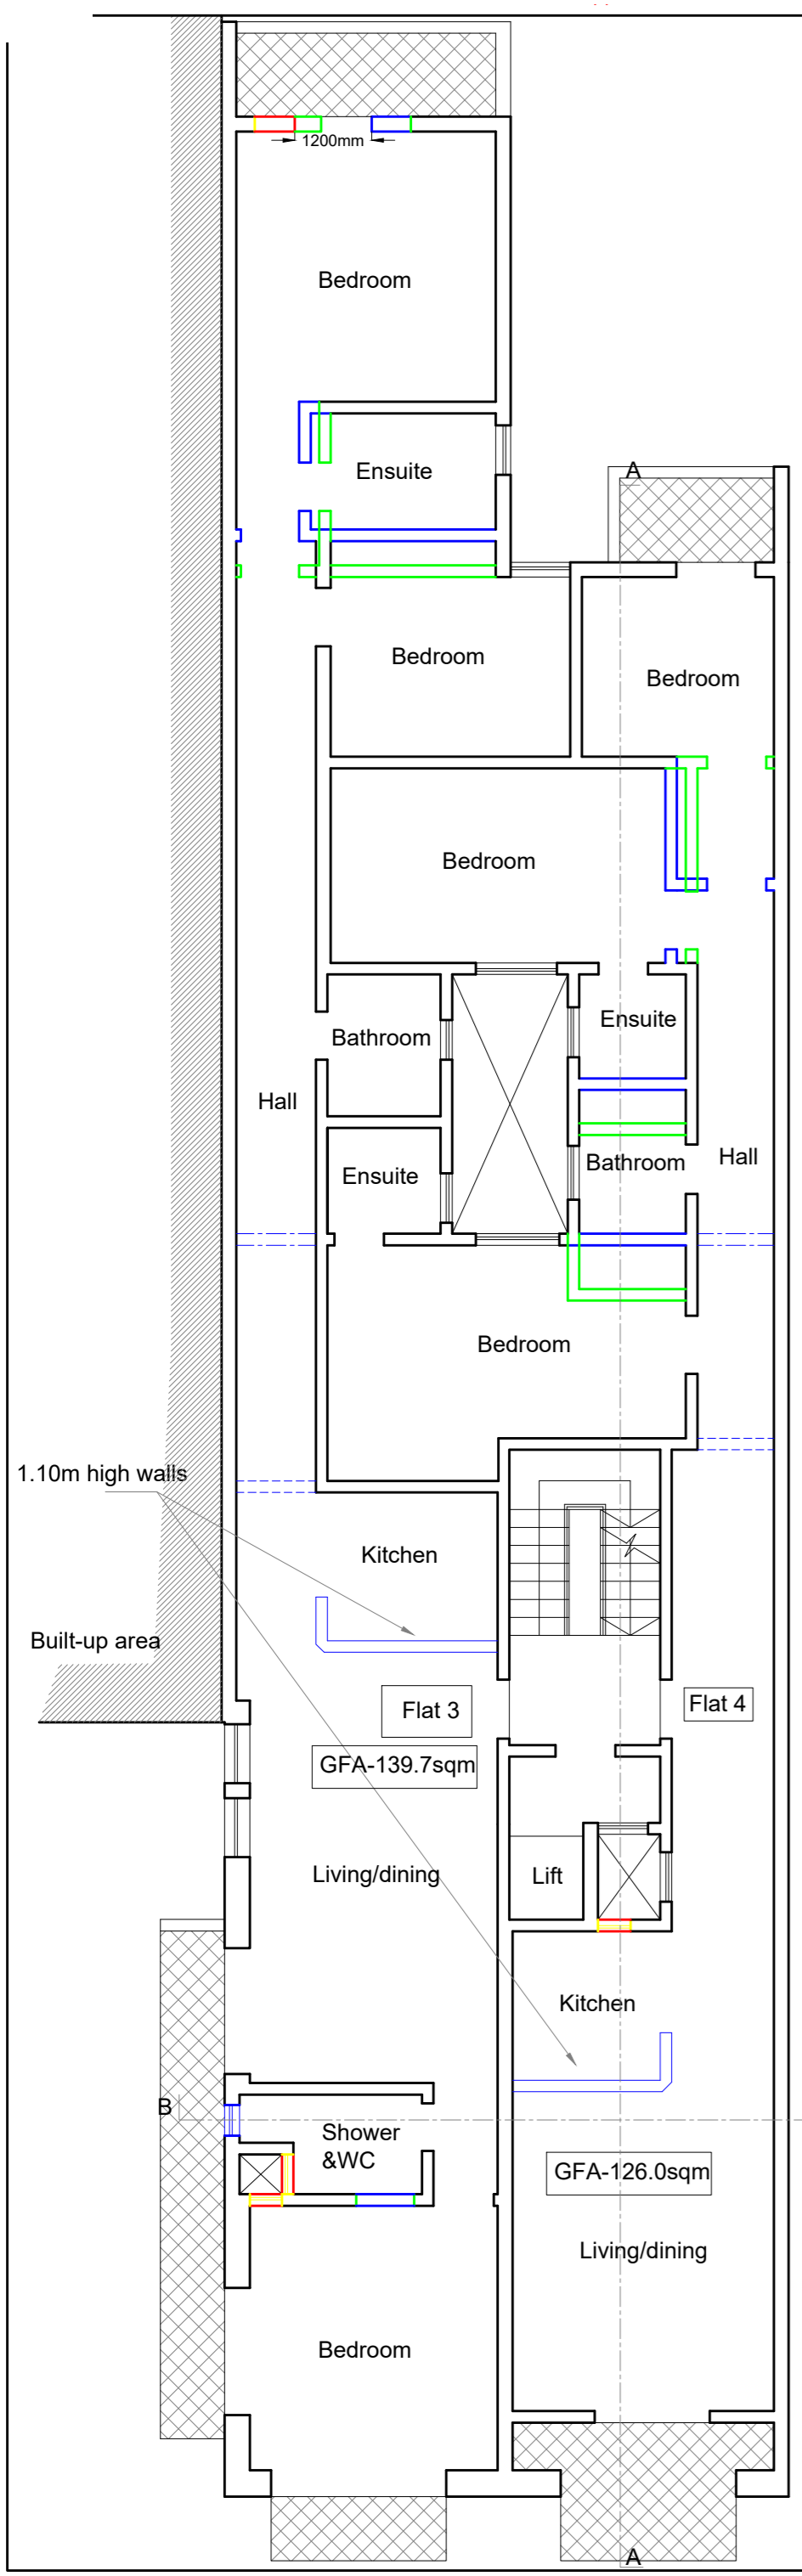


### Notes:


- As constructed, to sanction
- Approved but not constructed, to sanction
- Construction proposed
- Demolition proposed

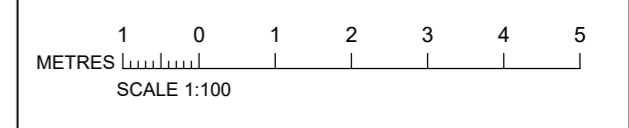

**As built and Proposed First floor**  
Scale 1:100

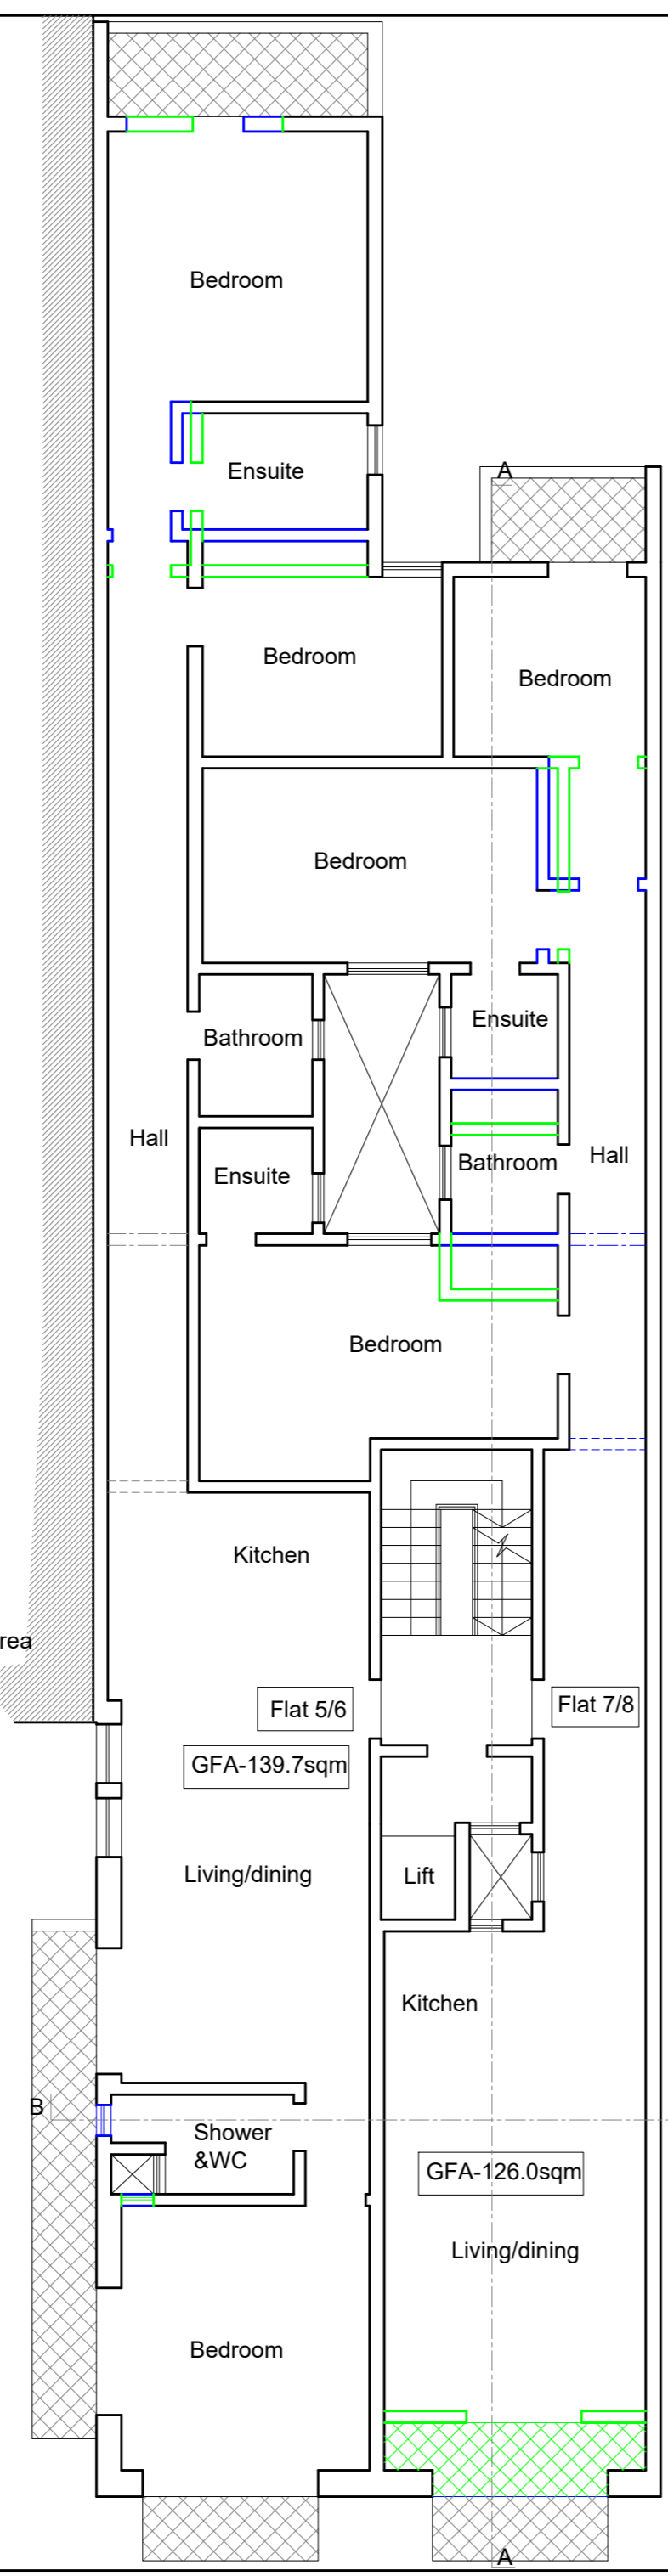

**As built Second and third floors**  
Scale 1:100

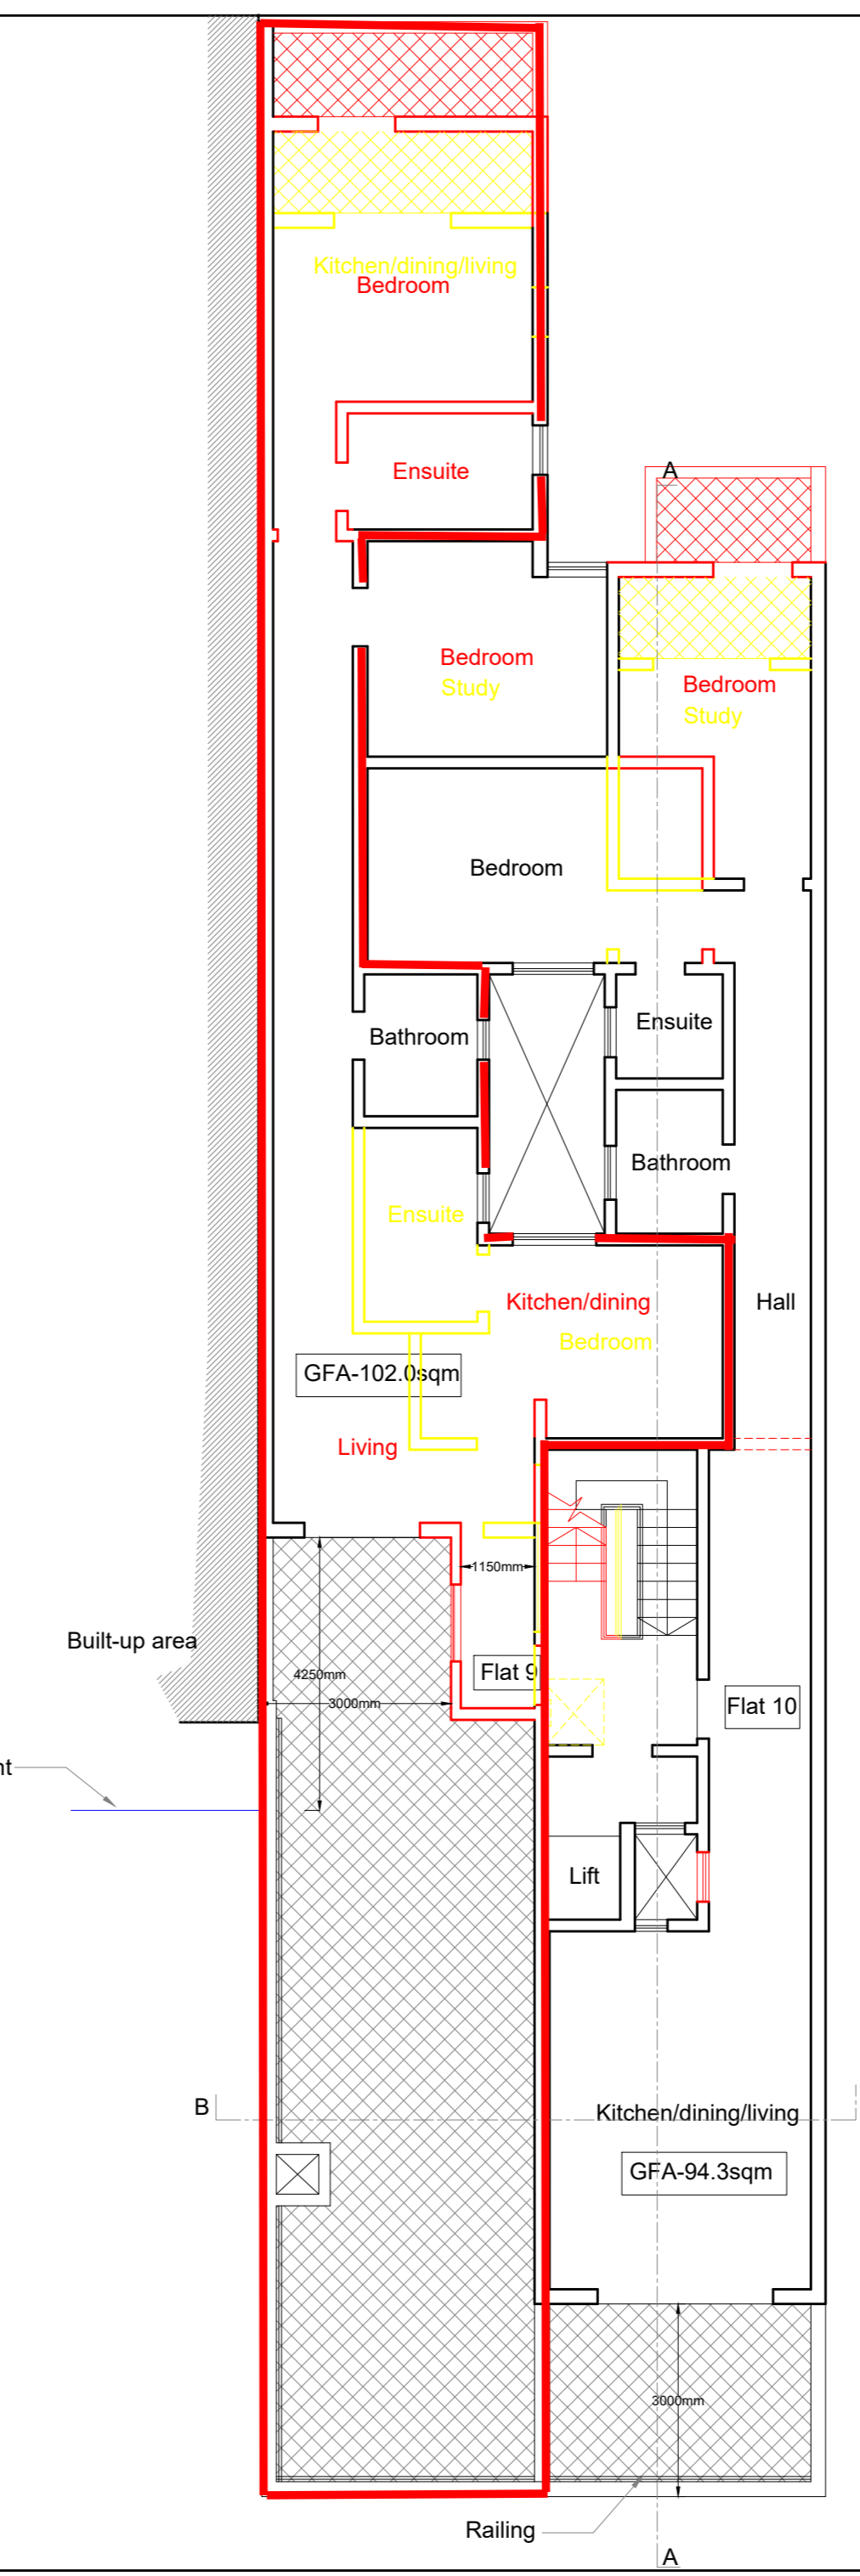

**Proposed Setback floor**  
Scale 1:100