




01 APPROVED RECESSED FLOOR AS PER PA/00989/19
PA100 1:100

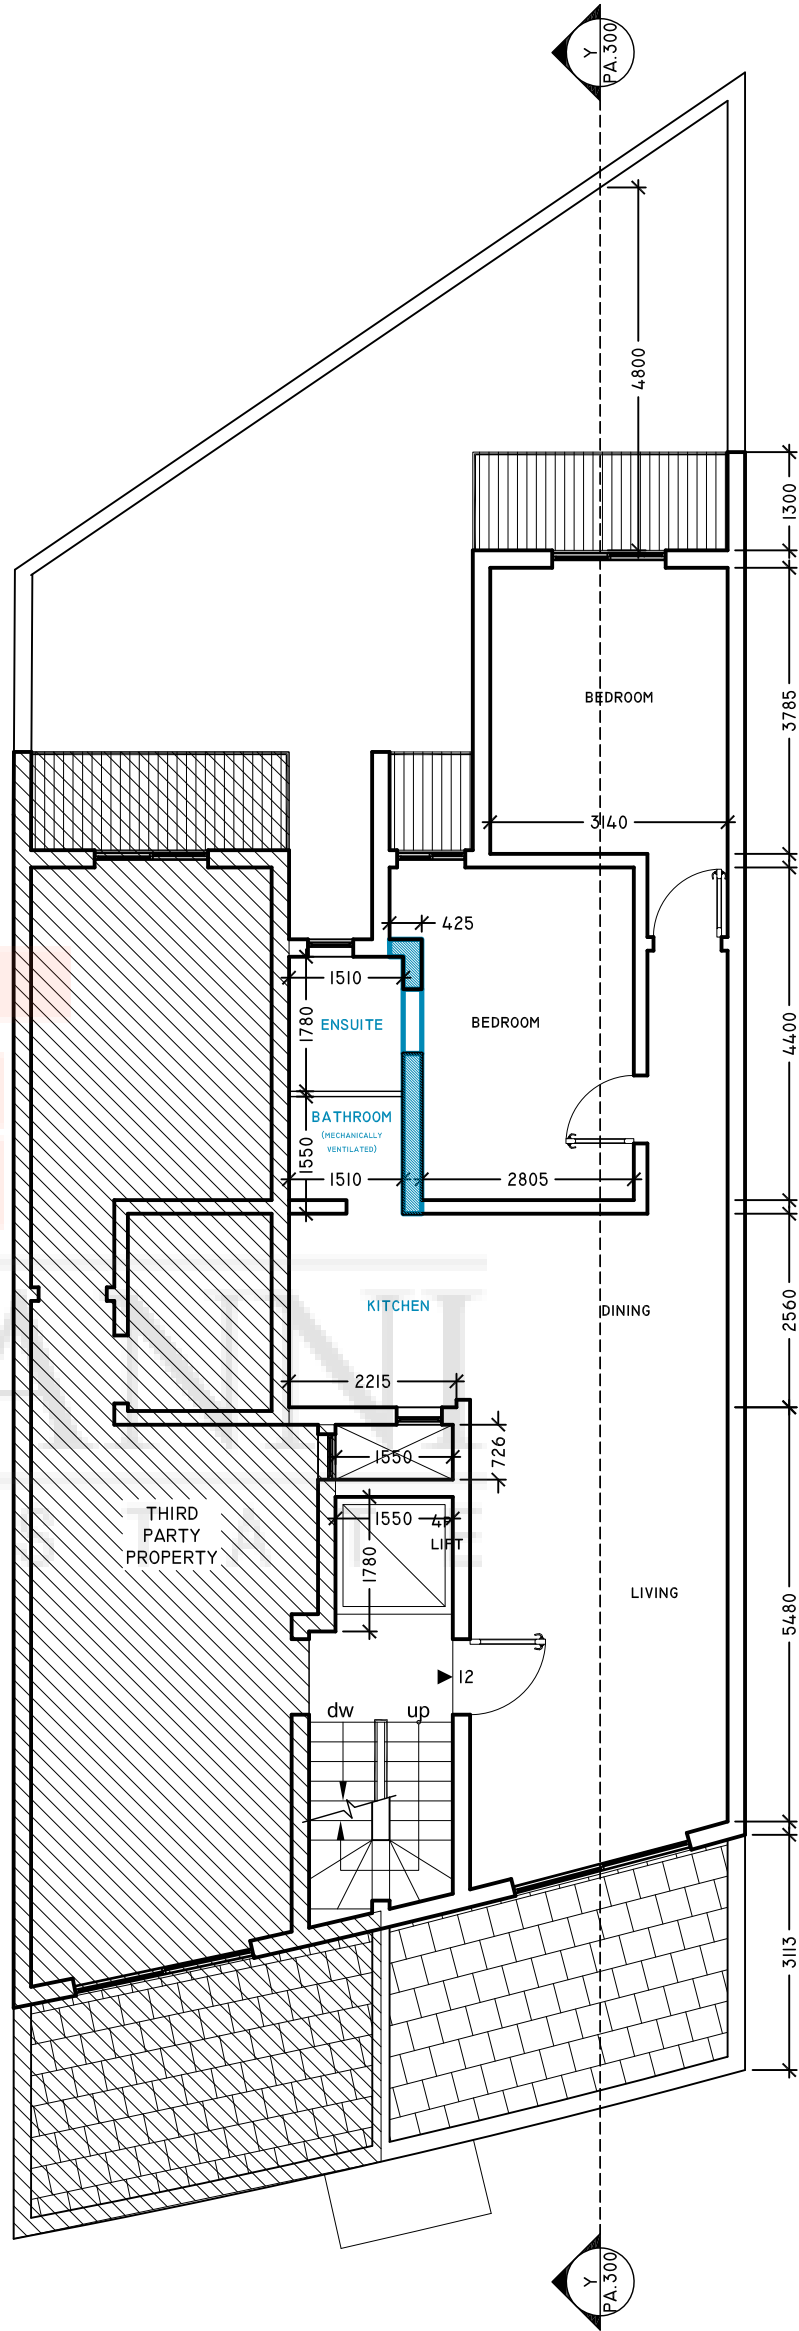


02 AS-BUILT RECESSED FLOOR (TO SANCTION)
PA100 1:100

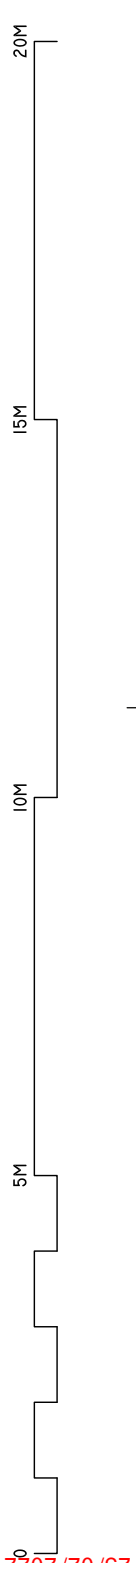

- As approved
- As proposed
- As Approved but not constructed
- As Constructed (to sanction)

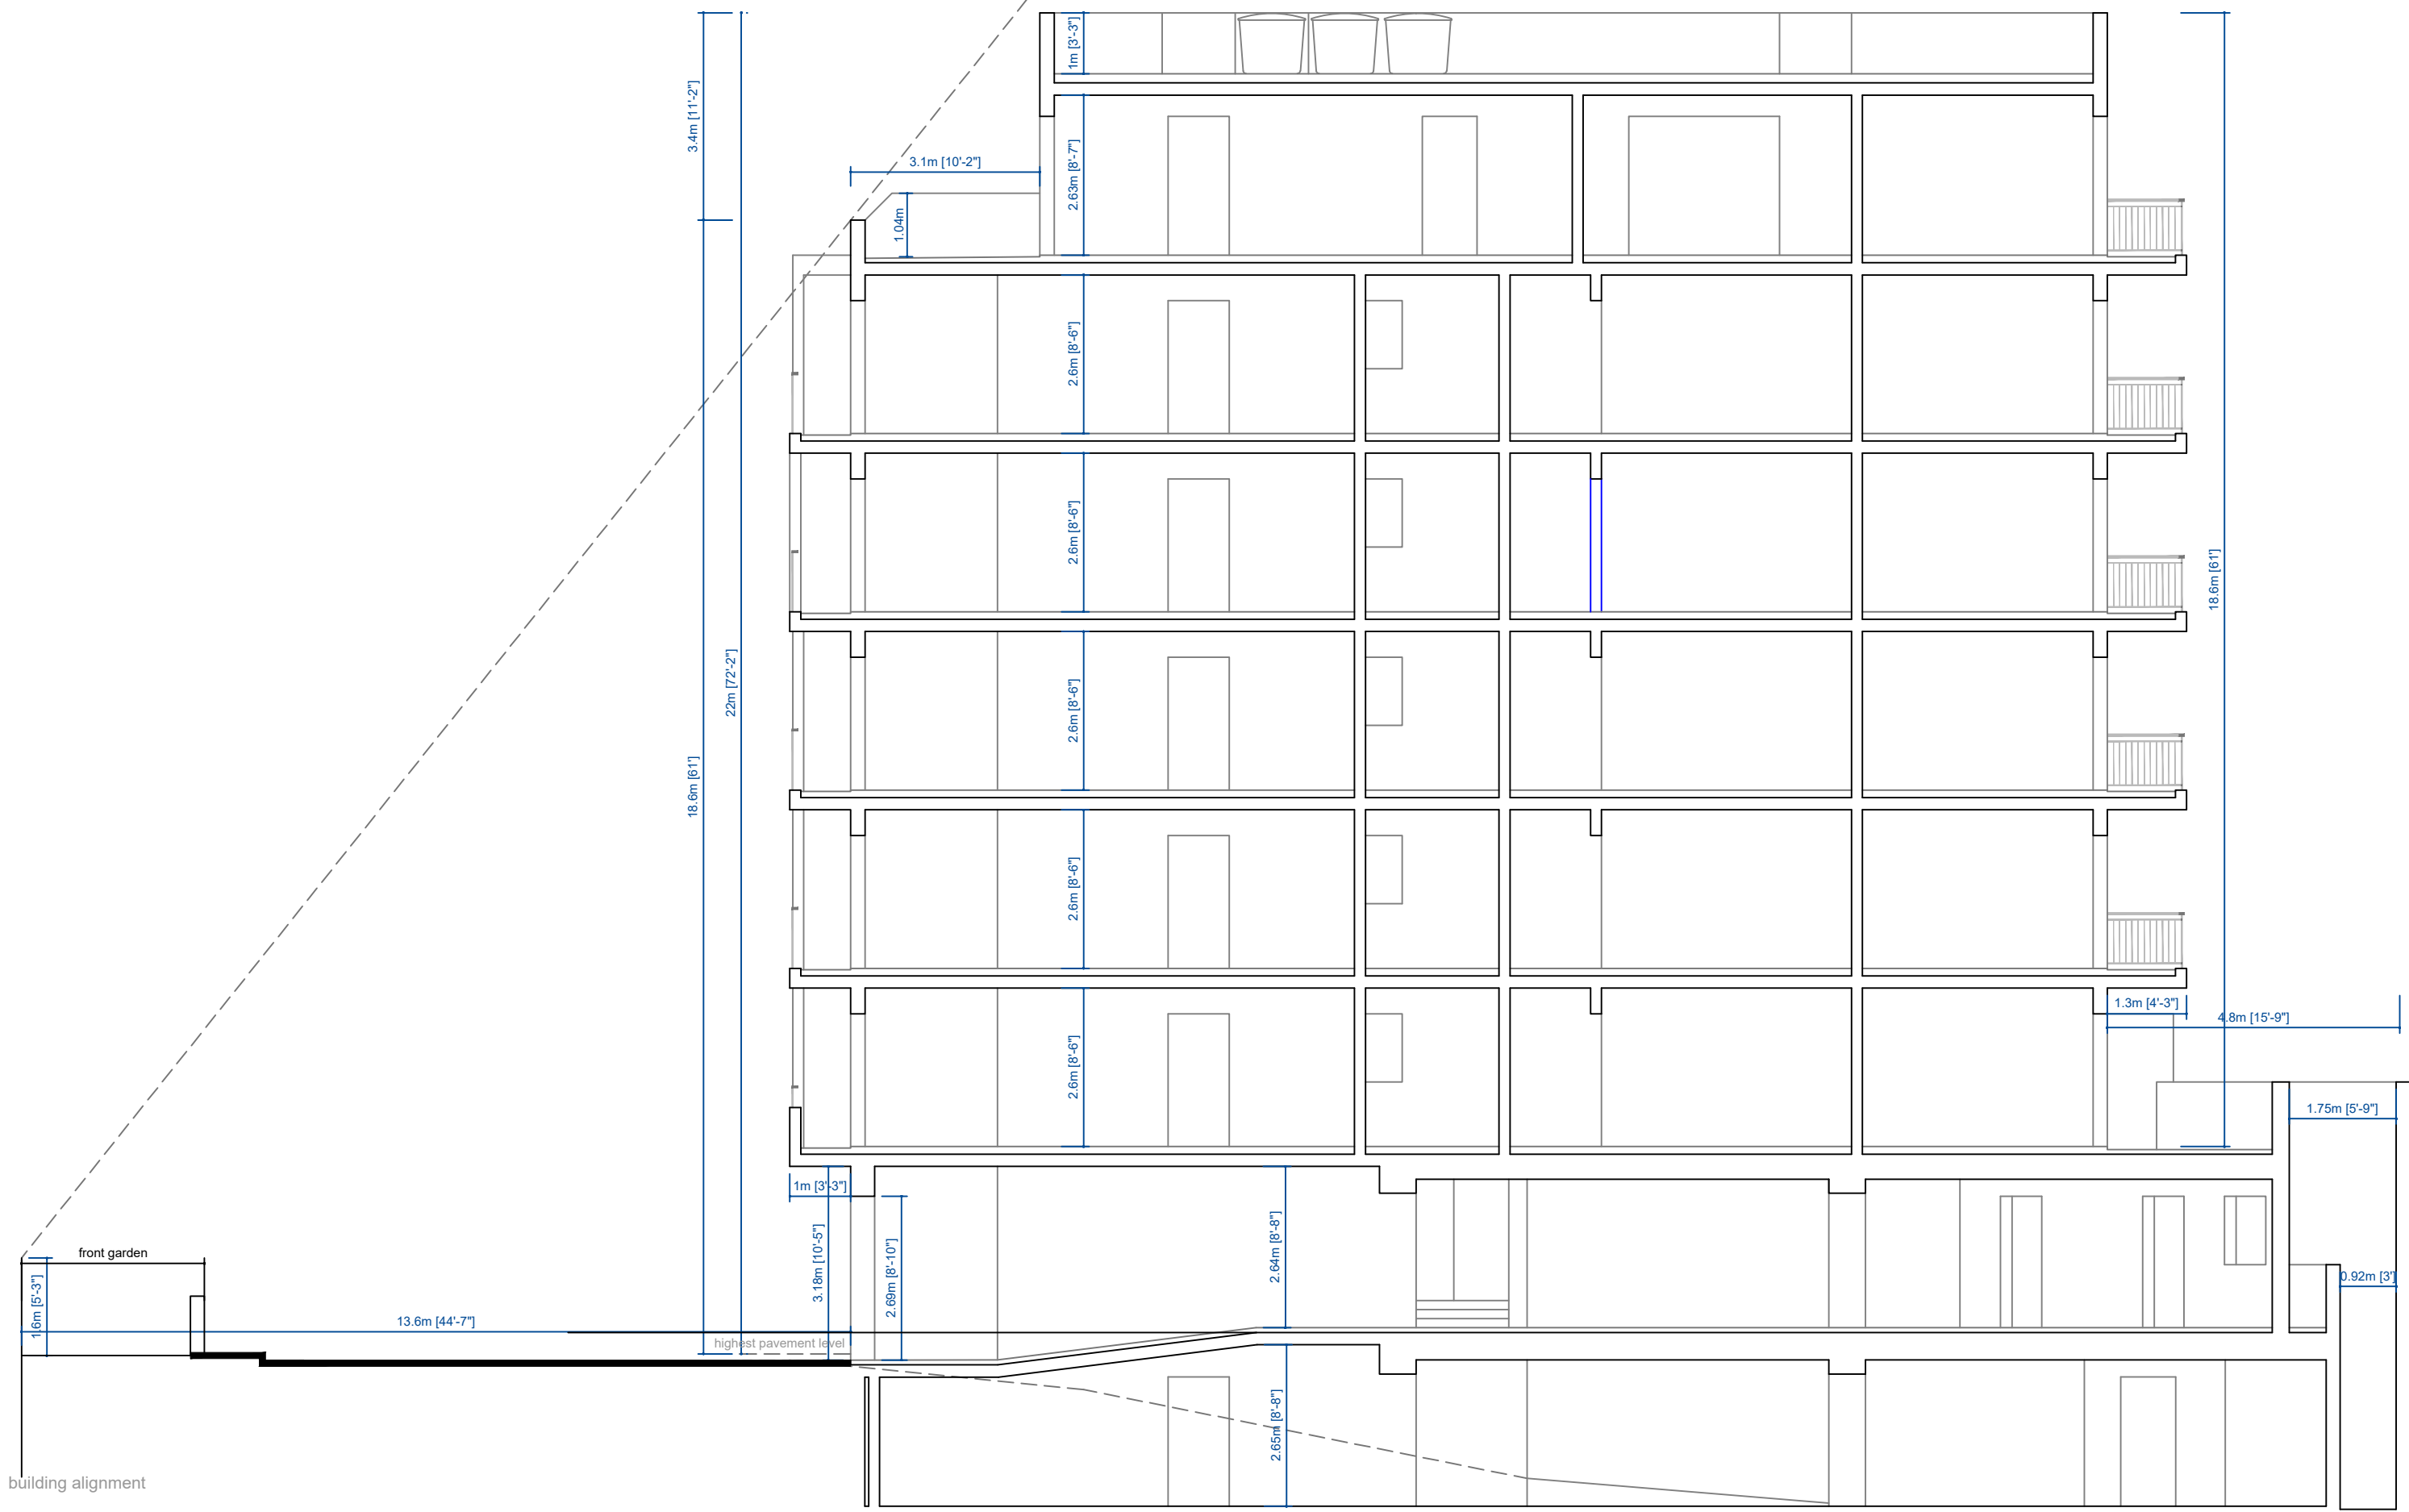

proposed longitudinal section through Y-Y

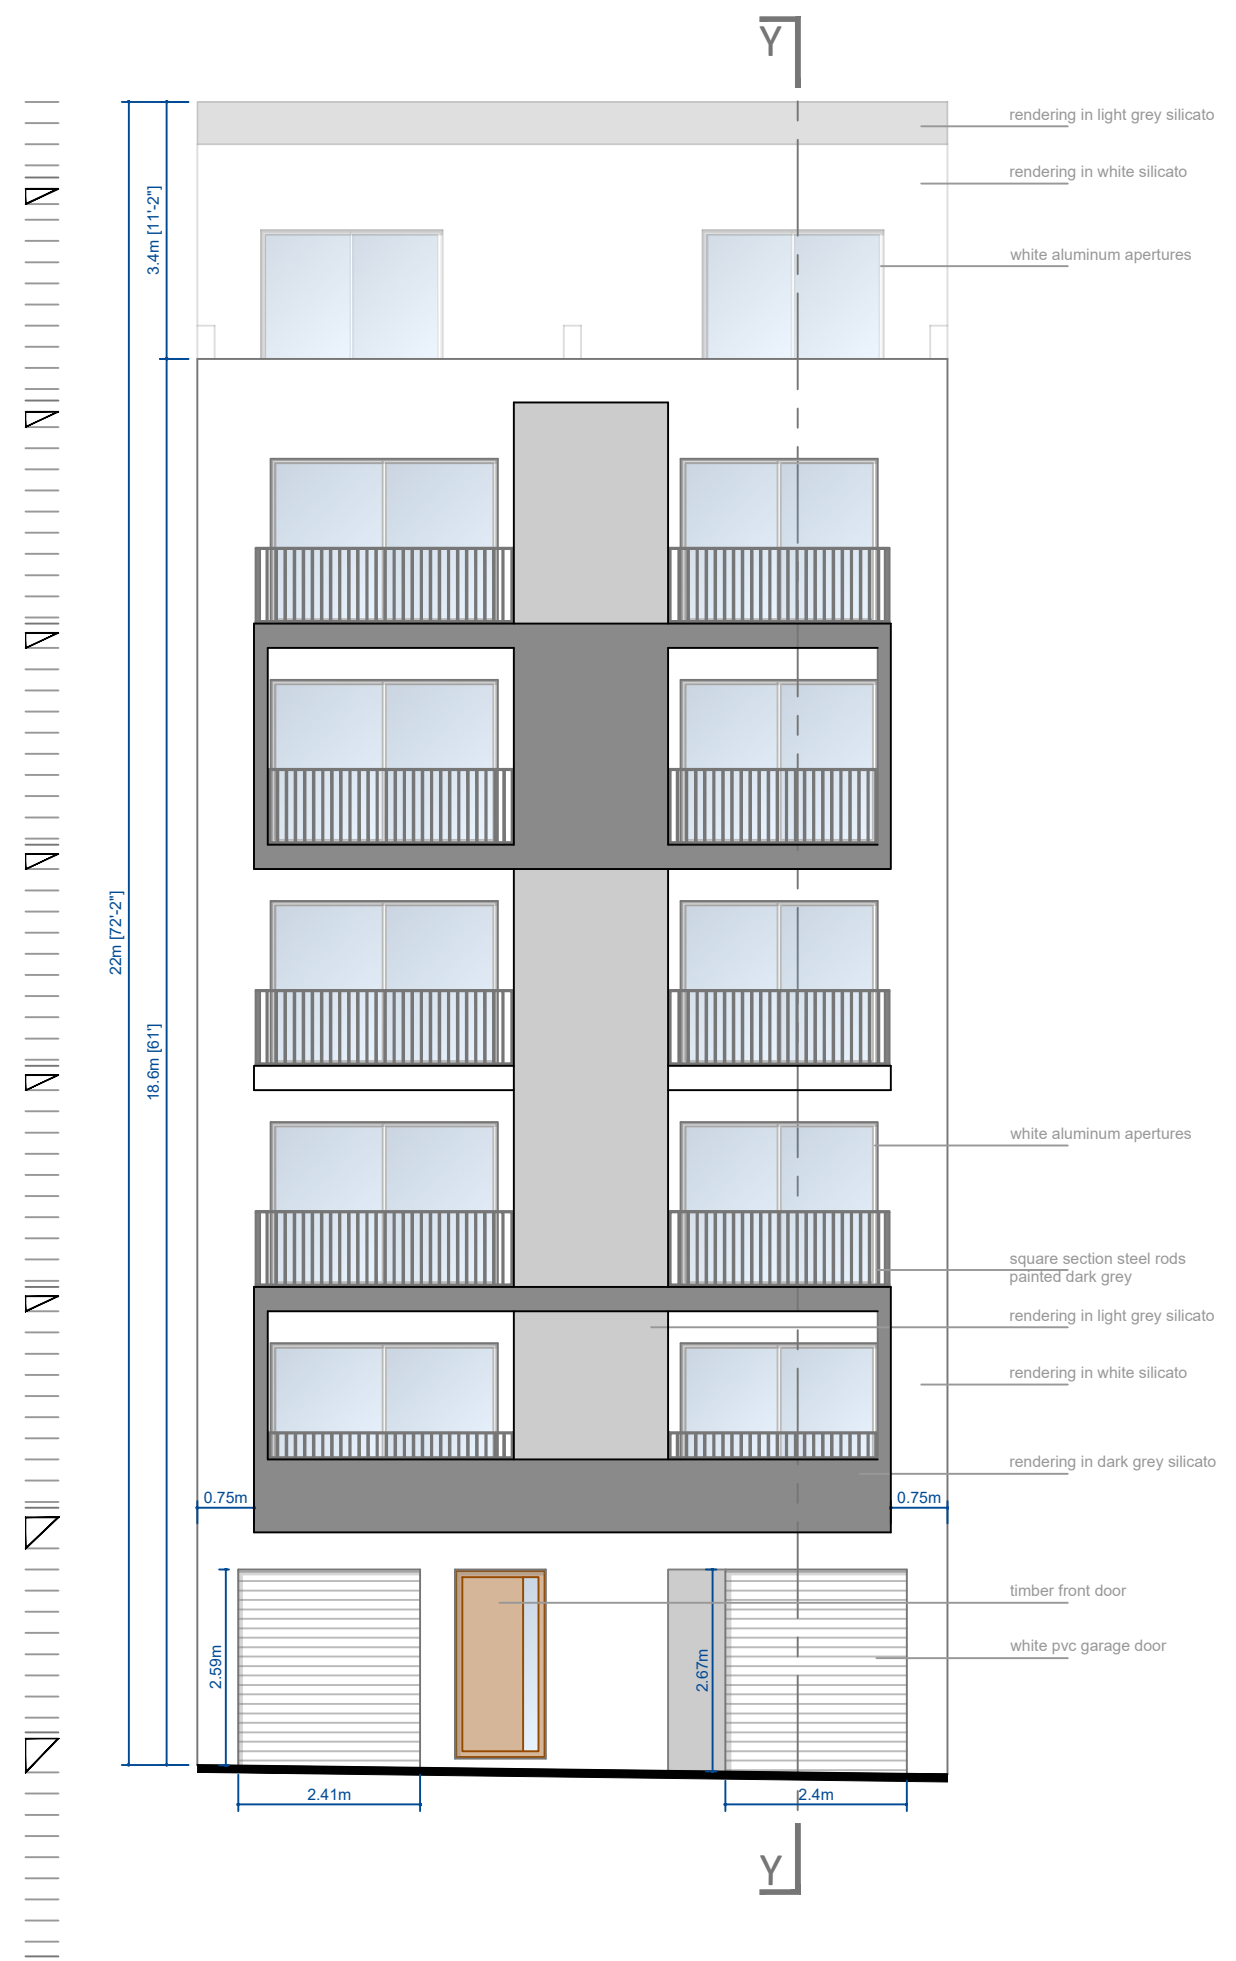

proposed elevation