




AS APPROVED IN  
SCALE 1:100

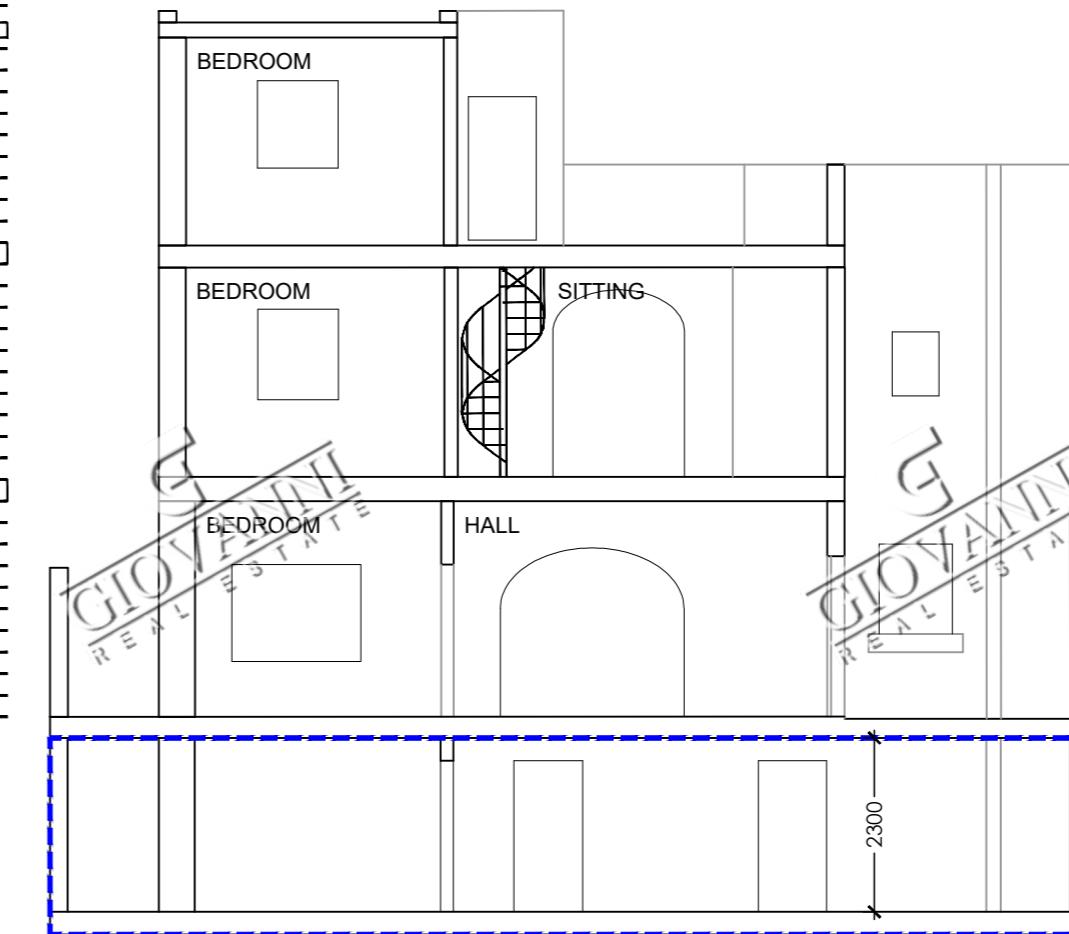

AS BUILT SECTION  
SCALE 1:100

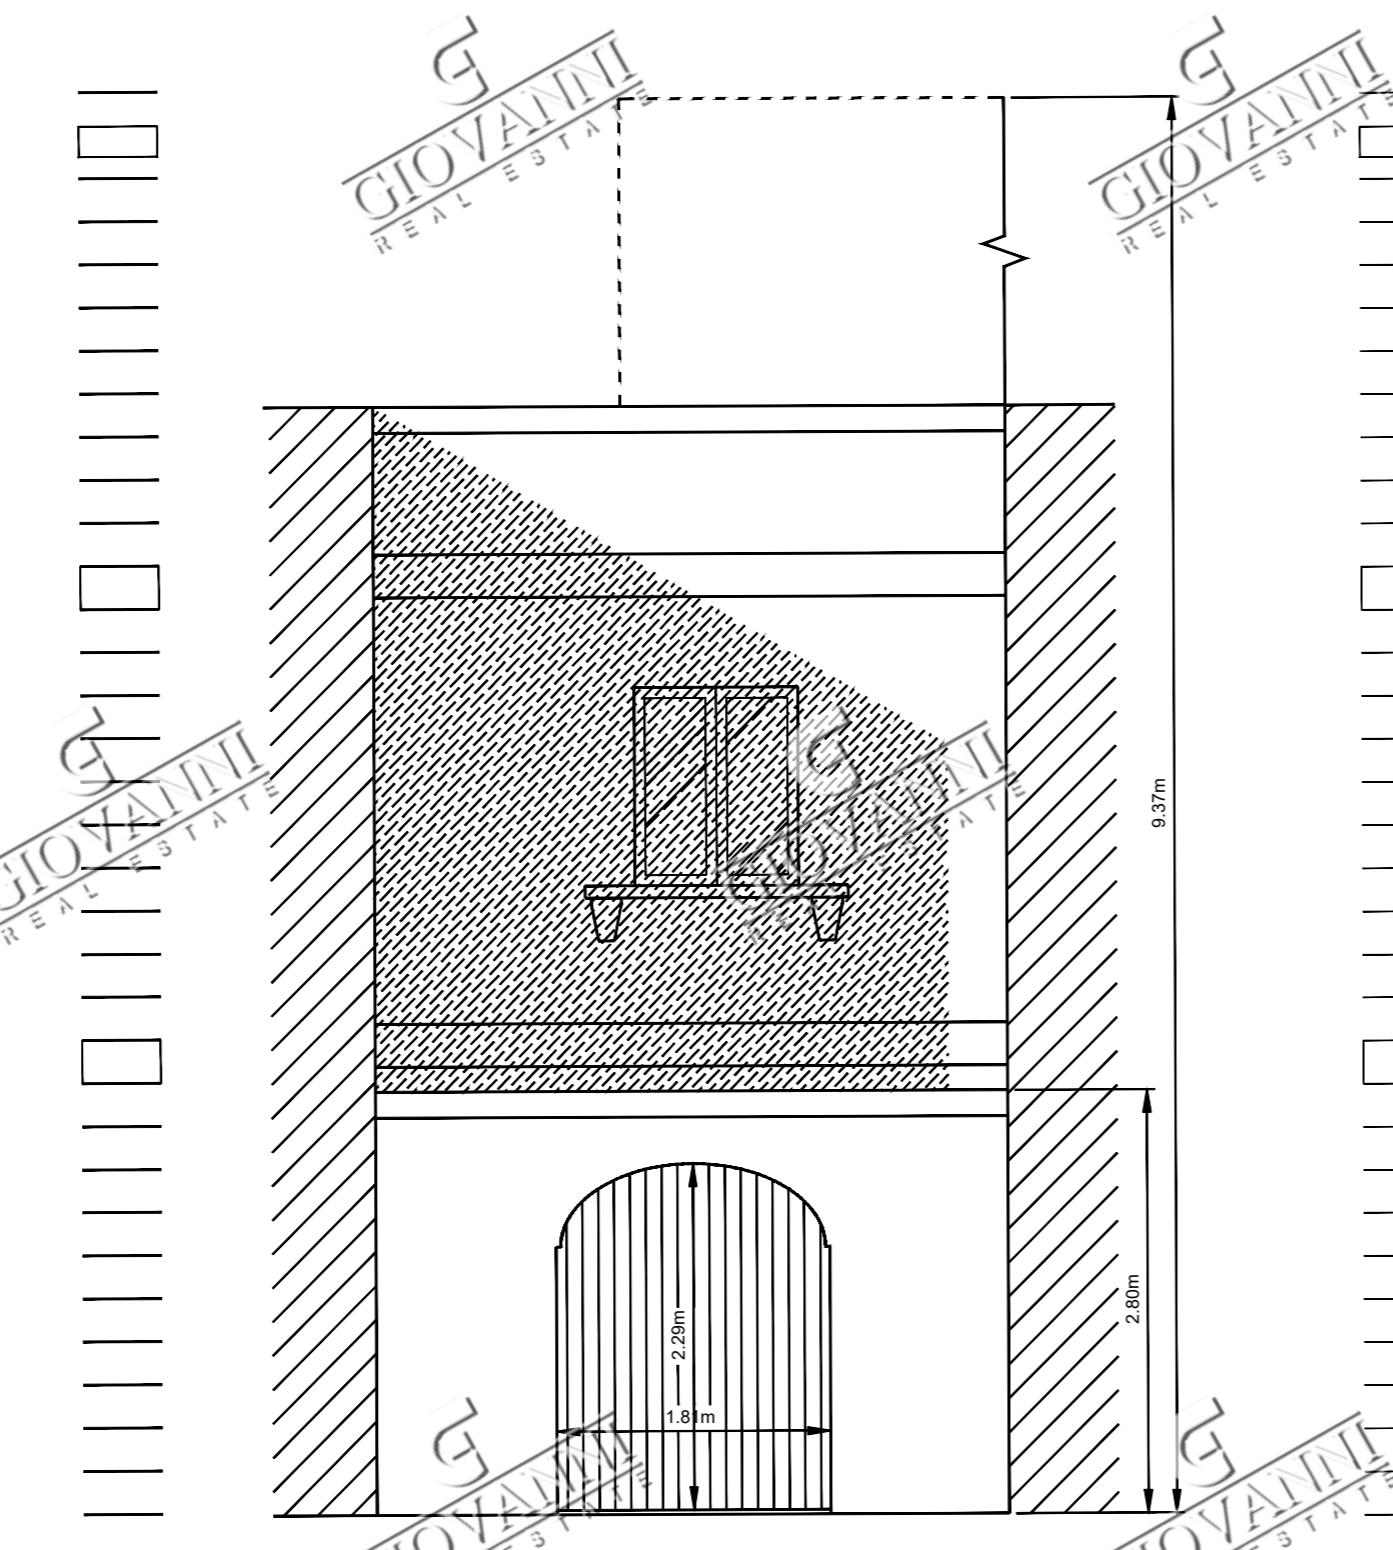

AS APPROVED IN  
SCALE 1:50

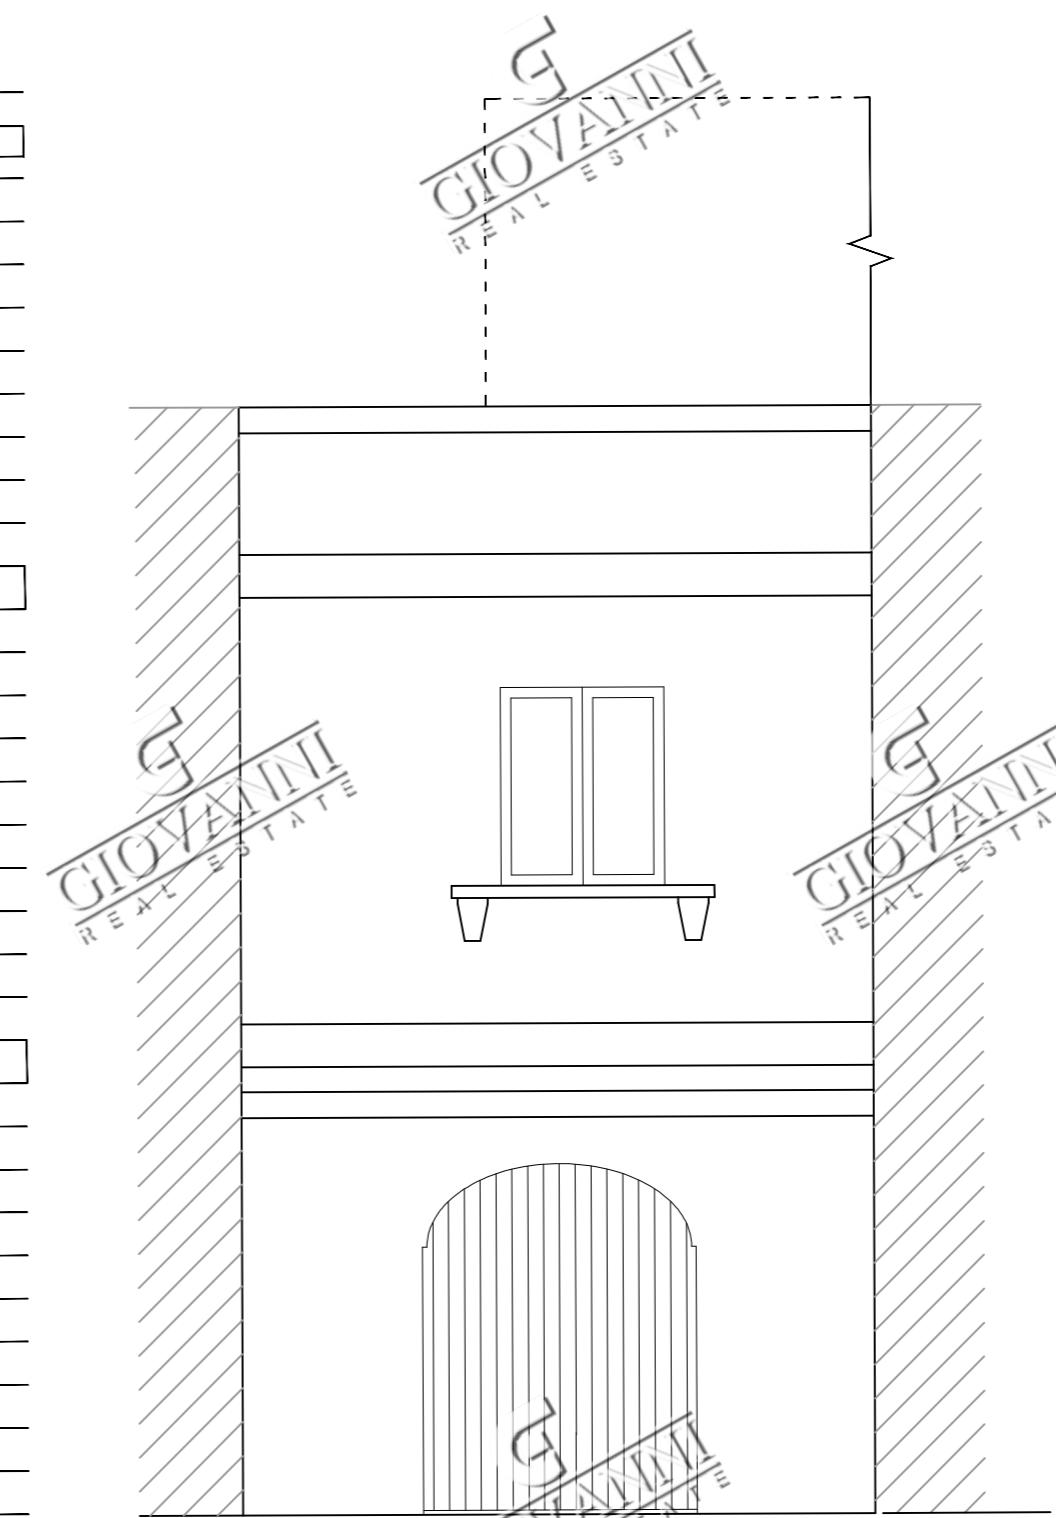

AS BUILT ELEVATION-NO CHANGES  
SCALE 1:50

AS BUILT

